IREDELL COUNTY HEALTH DEPARTMENT

Statesville Phone TR 3-7271 Mooresville Phone NO 3-1271

PERMIT TO INSTALL SEPTIC TANK

Permit NO. _____ Permit Date SEPT 22 19 61

LEE BROS, CHARLOTTE

Owner MARVIN HUFFMAN Address RFD STATESVILLE

Installed By CLYDE HOKE Address _____


Location of Property ACROSS FROM MORRONS STORE AT INTERSECTION OF RIVER ROAD & SHARON SCHOOL ROAD

Tank		Capacity		Length of Lines		Fixtures	
Block	( )	800	( )	150'	( )	No. of Baths	(1)
Precast	(✓)	900	( )	175'	( )	Dishwasher	( )
		1000	(✓)	200'	( )	Garbage Grdr.	( )
		1100	( )	225'	(✓)	Auto-Washer	( )
		1200	( )	250'	( )	Other _____	
		Other _____		Other _____			

NOTIFY HEALTH DEPARTMENT AT LEAST EIGHT HOURS BEFORE TANK IS TO BE INSPECTED.

Final Inspection SEPT 27 19 61 Approved (✓) Disapproved ( )

Remarks _____

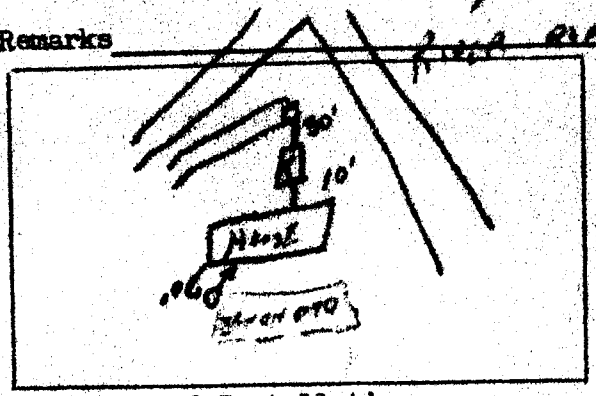

Sketch of Installation

Raford G. Adams

Sanitarian