14050.

# IREDELL COUNTY HEALTH DEPARTMENT

## IMPROVEMENT PERMIT AND CERTIFICATE OF COMPLETION / OPERATIONS PERMIT

OWNER OR CONTRACTOR MICHAEL PENDERGRASS DATE 4-16-92. PERMIT NO. 8P-A-106.

PHONE: Business _____ Home _____

LOCATION Hwy 21 Schoolfield north of I-40 W- Doublewide on left just before Ingles Supermarket. S.R. No. _____

SUBDIVISION NAME _____ LOT NO. _____ SECTION OR BLOCK NO. _____

DOUBLEWIDE.

House ☐ Mobile Home ☑ Business ☑ Other _____

No. Bedrooms 3 No. Bathrooms 2

Garbage Disposal Unit Yes ☐ No ☑

Auto. Dishwasher Yes ☑ No ☐

Auto. Wash. Machine Yes ☑ No ☐

Lot Area 2 acres.

Soil Characteristics Prev. Suitable.


Application Rate .4 gal./sq. ft.

Topography 2-8% 10+

Depth to Water Table _____

Rock or other impervious formations none observed.

_____ Basement with Plumbing _____ Basement without Plumbing ✓ No Basement _____ Crawl Space

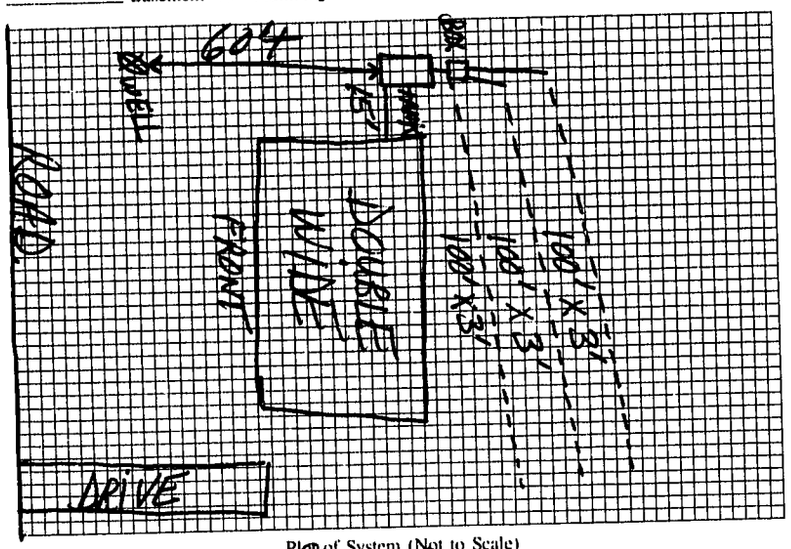


Plan of System (Not to Scale)

Size of Tank 1000 Gals.

Nitrification Field:

No. of Lines 3

Sq. Ft. 900 Linear Ft. 300

Depth of Stone in Lines 12

Water Supply: Individual ☑ Public ☐

Installed by Chaffin Farms

I understand and agree to install a septic tank system as specified on this Improvement Permit.

Signed: _____

(IMPROVEMENT PERMIT IS VALID FOR 60 MONTHS FROM DATE OF ISSUE.)

IMPROVEMENT PERMIT BY Steve Brown

COMMENTS _____

CERTIFICATE OF COMPLETION BY Steve Brown DATE 4-16-92.

EXISTING SYSTEM CHECKED BY _____ DATE _____

CONSTRUCTION MUST COMPLY WITH ALL OTHER APPLICABLE STATE AND LOCAL REGULATIONS

Permit is VOID if any unauthorized changes are made in installation of system, and/or if any unapproved changes are made to the site, and/or if any false information is supplied toward securing Improvement Permit.

Health Dept. Copy: White Inspection Dept. Copy: Yellow Sanitarian's Copy: Pink Owner's Copy: Gold