IREDELL COUNTY HEALTH DEPARTMENT

Statesville Phone TR 3-7271 Mooresville Phone NO 3-1271

PERMIT TO INSTALL SEPTIC TANK

Permit Date 6 Nov 1958

Permit NO. _____

Owner Morrow Bros. Address Sharon

Installed By L Hobe Address R7 - Statesville


Location of Property River Rd. at X Rds, new brick store on Right -

Tank		Capacity		Length of Lines		Fixtures	
Block	( )	800	(1)	150'	(1)	No. of Baths	(1)
Precast	(1)	900	( )	175'	( )	Dishwasher	( )
		1000	( )	200'	( )	Garbage Grdr.	( )
		1100	( )	225'	( )	Auto-Washer	( )
		1200	( )	250'	( )	Other _____	
		Other _____		Other _____			

NOTIFY HEALTH DEPARTMENT AT LEAST EIGHT HOURS BEFORE TANK IS TO BE INSPECTED.

Final Inspection 6 Nov 195 8 Approved (1) Disapproved ( )

Remarks None

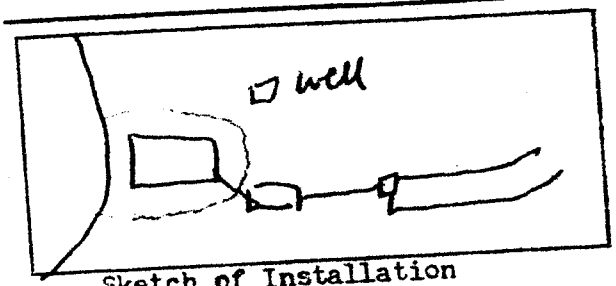

Sketch of Installation

R. A. 2

Sanitarian