IREDELL COUNTY HEALTH DEPARTMENT

STATESVILLE 704-878-5305 (CI) MOORESVILLE 704-664-5281

IMPROVEMENT PERMIT / AUTHORIZATION TO CONSTRUCT / OPERATION PERMIT / EXISTING SYSTEM INSPECTION

PERMIT# 119138 PIN# 3984-80-6224 DATE 3/16/04

OWNER OR CONTRACTOR Southerland Land + Development Inc PHONE: Business (704) 876-1080 Home —

ADDRESS 125 Green Field Drive Statesville N.C. 28625

LOCATION I-40 W, @ Sharon School Rd, 2 miles on Right

SUBDIVISION Sharon Trace BLOCK / SECTION — LOT 42 LOT AREA .51 Acres SITE CLASS. PS DESIGN FLOW 360 L.T.A.R. .25 gpd/ft²

Septic Tank: 1,000 Gallons; STB 1012 Date 8-1-04
Pump Tank: — Gallons; PT — Date —
Pump Make: — Model — Serial No. —
Nitrification Field: No Fields 1 Square Feet 1440 Linear Feet 360
No Lines 5 Trench Width 36" Max Trench Bottom Depth 32" Gravel Depth N/A

☒ New System ☐ Repair System Type: I, II, (III) IV, V, VI
System Description: Gravity 25% Reduction
Repair System Description: LP Panels
Maintenance Agreement Required: ☐ Yes ☒ No

☒ House/Mod. Home No. Bedrooms 3
☐ Mobile Home No. Bathrooms 2
☐ Business No. Employees —
☐ Other —


☒ Slab ☐ Crawl Space ☐ Basement w/plumbing ☐ Basement wo/plumbing

Water Supply: ☐ Individual ☒ Public ☐ Community

Comments:/Conditions: ① Maintain Prop. setback ② Install lines on contour


Comments:/Conditions: SEPTIC TANK WITH MARKER INSTALLED USING "TUFTITE" FILTER. SYSTEM INSTALLED DURING PERIOD OF WET SOIL CONDITIONS.

INITIAL SITE SKETCH

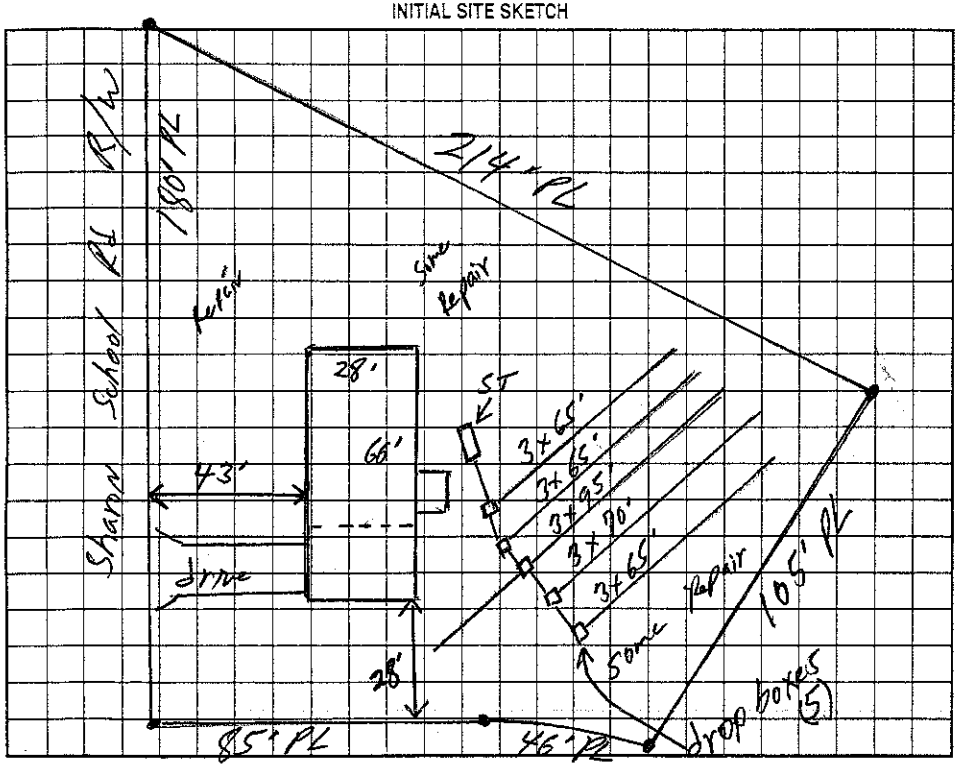

AS BUILT SKETCH

INSTALLED AS SHOWN BELOW WITH PRIOR HEALTH DEPARTMENT APPROVAL.

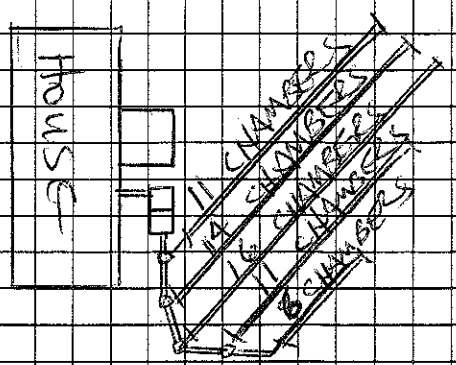

Permit can be suspended or revoked if any false information is supplied toward securing the permit/any unauthorized changes are made to the site/any unauthorized changes are made in the installation of the system. Improvement Permit with plat valid without expiration. Improvement Permit with site plan valid for sixty months. Authorization to Construct is valid for a period equal to that of Improvement Permit – not to exceed sixty months.

Signed [signature] date 03-16-04 Installed by: FOREST STAFFORD

Improvement Permit by: William O. Johnson date 3/16/04 Operation Permit by: STEVE HEDRICK date 3-9-05

Authorization to Construct by: William O. Johnson date 3/16/04 Existing System Inspection by: — date —

HEALTH DEPT. COPY: WHITE OWNER COPY (FINAL): YELLOW OWNER COPY (INITIAL): PINK