IREDELL COUNTY HEALTH DEPARTMENT

STATESVILLE 704-878-5305 MOORESVILLE 704-664-5281

IMPROVEMENT PERMIT / AUTHORIZATION TO CONSTRUCT / OPERATION PERMIT / EXISTING SYSTEM INSPECTION

PERMIT# 119132 PIN# 3784-80-7130 DATE 3/16/04

OWNER OR CONTRACTOR Southerland Land + Development Inc PHONE: Business (704) 876-1080 Home

ADDRESS 125 Greenfield Drive Statesville NC 28625

LOCATION I-40 W, (R) Sharon School Rd. 2miles on the right

SUBDIVISION Sharon Trace BLOCK / SECTION — LOT 8 LOT AREA .56 Ac. SITE CLASS. PS DESIGN FLOW 360 L.T.A.R. .25 gpd/ft2

Septic Tank: 1000 Gallons; STB 1012 Date 8-1-04

Pump Tank: Gallons; PT Date

Pump Make: Model Serial No.

Nitrification Field: No Fields 1 Square Feet Exc. to 1440 Linear Feet 360

No Lines 4@90 Trench Width 36" Max Trench Bottom Depth 30" Gravel Depth NA

☒ New System ☐ Repair System Type: I, II, (III), IV, V, VI

System Description: Gravity, 25% Reduction

Repair System Description: LP Panel

Maintenance Agreement Required: ☐ Yes ☒ No

☒ House/Mod. Home ☐ Mobile Home ☐ Business ☐ Other

No. Bedrooms 3 No. Bathrooms 2 No. Employees


☒ Slab ☐ Crawl Space ☐ Basement w/plumbing ☐ Basement wo/plumbing

Water Supply: ☐ Individual ☒ Public ☐ Community


Comments:/Conditions: (1) maintain proper set backs (2) Install lines on contour (3) Remove Old field terraces

Comments:/Conditions: SEPTIC TANK WITH MARKER INSTALLED USING "TUFTITE" FILTER CHECKED 2-17-05 RSH

INITIAL SITE SKETCH

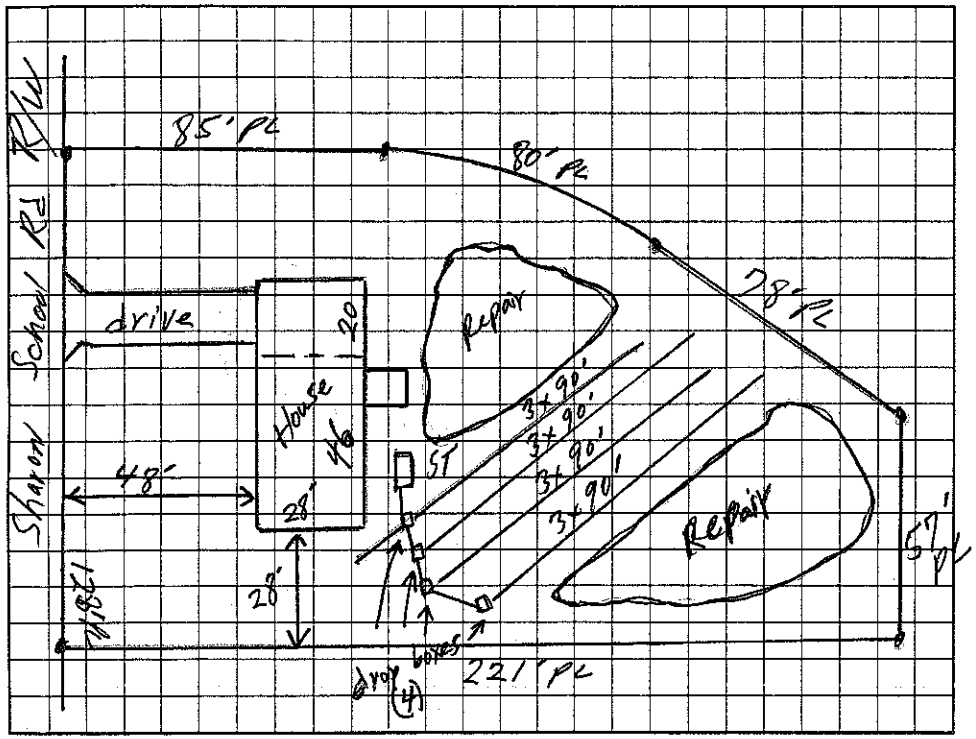

AS BUILT SKETCH

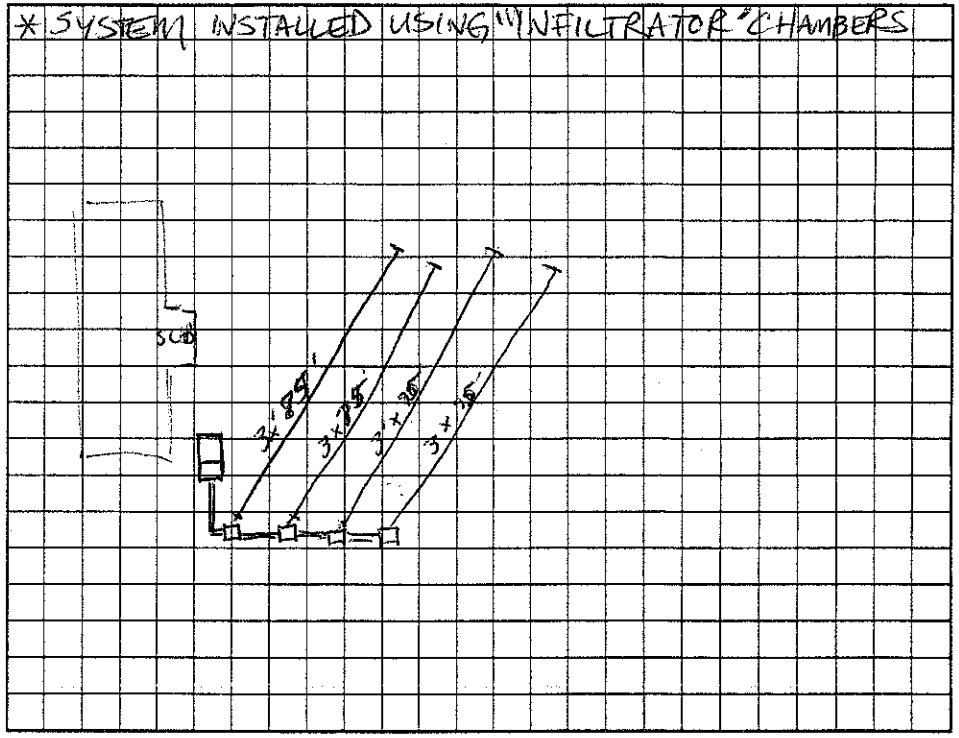

Permit can be suspended or revoked if any false information is supplied toward securing the permit/any unauthorized changes are made to the site/any unauthorized changes are made in the installation of the system. Improvement Permit with plat valid without expiration. Improvement Permit with site plan valid for sixty months. Authorization to Construct is valid for a period equal to that of Improvement Permit – not to exceed sixty months.

Signed: date 03-16-04 Installed by: FOREST SHUFORD

Improvement Permit by: William O. Johnson date 3/16/04 Operation Permit by: Christopher M Shuford, RS,LSS date 2-18-05

Authorization to Construct by: William O. Johnson date 3/16/04 Existing System Inspection by: date

HEALTH DEPT. COPY: WHITE OWNER COPY (FINAL): YELLOW OWNER COPY (INITIAL): PINK