IREDELL COUNTY HEALTH DEPARTMENT

STATESVILLE 704-878-5305 (01) MOORESVILLE 704-664-5281

IMPROVEMENT PERMIT / AUTHORIZATION TO CONSTRUCT / OPERATION PERMIT / EXISTING SYSTEM INSPECTION

PERMIT# 131714 PIN# 3784 80 8011 DATE 10/25/05

OWNER OR CONTRACTOR Dean Richon PHONE: Business 704 876 1080 Home

ADDRESS 792 Sharon School Rd Statesville, NC

LOCATION 140 west to Sharon School Rd - (R) property 1.5 miles on (R)

SUBDIVISION Sharon Trace BLOCK / SECTION LOT 7 LOT AREA .507 SITE CLASS PS DESIGN FLOW 360 L.T.A.R. .4

Septic Tank: 1000 Gallons; STB 1012 Date 4-27-05
Pump Tank: Gallons; PT Date
Pump Make: Model Serial No.
Nitrification Field; No Fields 1 Square Feet Approx. 700 Linear Feet 250
No Lines 4 Trench Width 3 Max Trench Bottom Depth 36 Gravel Depth N/A

☒ New System ☐ Repair System Type: I, II, III, IV, V, VI
System Description: 25% Reduction
Repair System Description: 50% Reduction
Maintenance Agreement Required: ☐ Yes ☒ No

☒ House/Mod. Home No. Bedrooms 3
☐ Mobile Home No. Bathrooms
☐ Business No. Employees
☐ Other


☐ Slab ☒ Crawl Space ☐ Basement w/plumbing ☐ Basement wo/plumbing

Water Supply: ☒ Individual ☐ Public ☐ Community

Comments:/Conditions:

Comments:/Conditions: SEPTIC TANK WITH MARKER INSTALLED USING "INFITE" FILTER

INITIAL SITE SKETCH

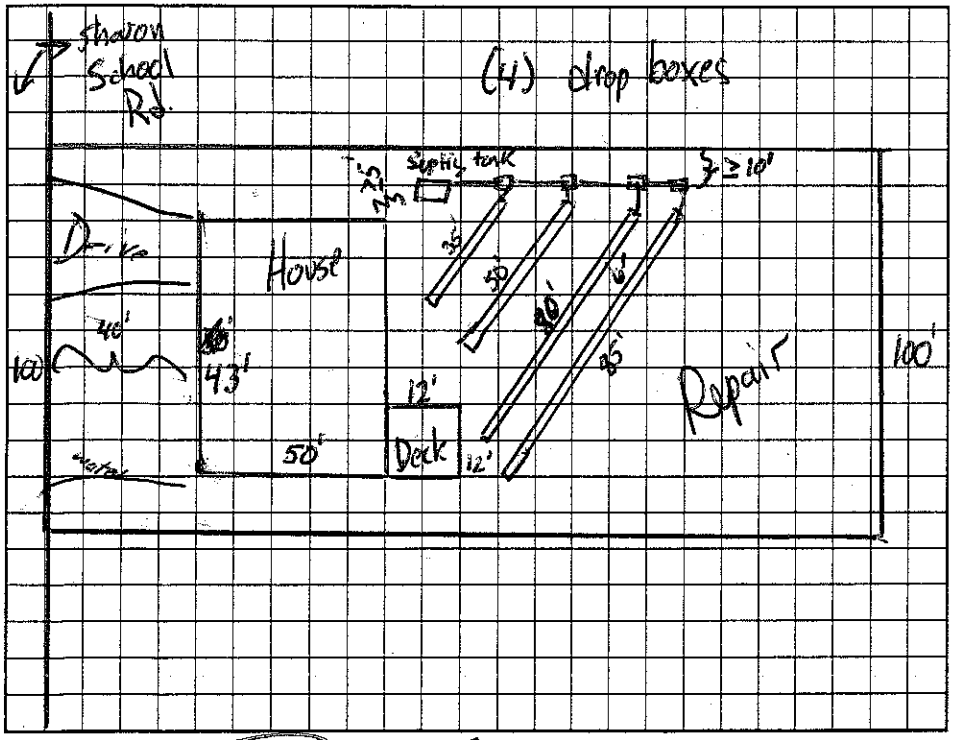

AS BUILT SKETCH

SYSTEM INSTALLED USING "QUICK-4" INFILTRATOR CHAMBERS AS SHOWN

Permit can be suspended or revoked if any false information is supplied toward securing the permit/any unauthorized changes are made to the site/any unauthorized changes are made in the installation of the system. Improvement Permit with plat valid without expiration. Improvement Permit with site plan valid for sixty months. Authorization to Construct is valid for a period equal to that of Improvement Permit – not to exceed sixty months.

Signed: [signature] date 10/25/05 Installed by: FOREST STAFFORD

Improvement Permit by: [signature] date 10/25/05 Operation Permit by: STEVE HERRICK date 12-2-05

Authorization to Construct by: [signature] date 10/25/05 Existing System Inspection by: date

HEALTH DEPT. COPY: WHITE OWNER COPY (FINAL): YELLOW OWNER COPY (INITIAL): PINK