IREDELL COUNTY HEALTH DEPARTMENT

STATESVILLE 704-878-5305 MOORESVILLE 704-664-5281

IMPROVEMENT PERMIT / AUTHORIZATION TO CONSTRUCT / OPERATION PERMIT / EXISTING SYSTEM INSPECTION

PERMIT# 79100 PIN# 3784 89 0205 DATE 2-12-99

OWNER OR CONTRACTOR George & Nelson PHONE: Business _____ Home 585 9551

ADDRESS _____

LOCATION Owner TL Anty Ln Sterling TR Linton TR Bolick TL Anty at Cnt.

SUBDIVISION _____ BLOCK / SECTION _____ LOT _____ LOT AREA 5.81 acres SITE CLASS. _____ DESIGN FLOW 360 GPD T.A.R. .3

Septic Tank: 1000 Gallons; STB 1012 Date 2-10-99

Pump Tank: _____ Gallons; PT _____ Date _____

Pump Make: _____ Model _____ Serial No. _____

Nitrification Field: No Fields 1 Square Feet 1200 Linear Feet 400

No Lines 4 Trench Width 36" Max Trench Bottom Depth 36" Gravel Depth 12"

☑ New System ☐ Repair System Type: I, II, III, IV, V, VI

System Description: Conv. Gravity

Repair System Description: " "

Maintenance Agreement Required: ☐ Yes ☑ No

☐ Slab ☑ Crawl Space ☐ Basement w/plumbing ☐ Basement wo/plumbing

☐ House/Mod. Home No. Bedrooms 3

☐ Mobile Home No. Bathrooms 2

☐ Business No. Employees _____

☐ Other _____


Water Supply: ☐ Individual ☐ Public ☐ Community

Comments/Conditions:


Comments/Conditions:

* Keep all Construction traffic off system

INITIAL SITE SKETCH

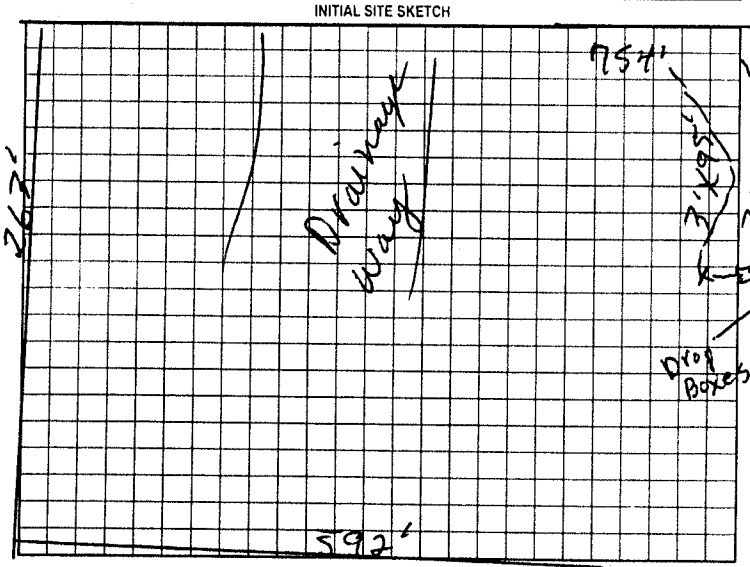

AS BUILT SKETCH

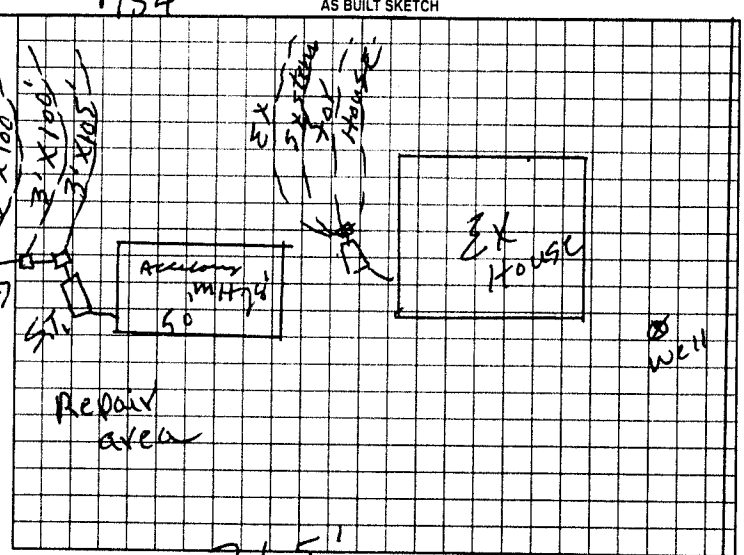

Permit can be suspended or revoked if any false information is supplied toward securing the permit/any unauthorized changes are made to the site/any unauthorized changes are made in the installation of the system. Improvement Permit with plat valid without expiration. Improvement Permit with site plan valid for sixty months. Authorization to Construct is valid for a period equal to that of Improvement Permit - not to exceed sixty months.

Signed: X Marlene J. Nelson date _____ Installed by: Tommy Trapp Cothern

Improvement Permit by: F. C. Moore date 2-12-99 Operation Permit by: [illegible] RS date 4-5-99

Authorization to Construct by: F. C. Moore date 2-12-99 Existing System Inspection by: _____ date _____

HEALTH DEPT COPY WHITE OWNER COPY (FINAL) YELLOW OWNER COPY (INITIAL) PINK