IREDELL COUNTY HEALTH DEPARTMENT

STATESVILLE 704-878-5305 MOORESVILLE 704-664-5281

IMPROVEMENT PERMIT / AUTHORIZATION TO CONSTRUCT / OPERATION PERMIT / EXISTING SYSTEM INSPECTION

PERMIT# 13337 PIN# 3784908859 DATE 5-10-06

OWNER OR APPLICANT Anthony Wagner PHONE: Business 704-585-9284 Home

ADDRESS 135 Wild Rabbit RD

LOCATION On (R) (R) (R) Sterling RD under 3 bdg (R) Bridge 1 mile up Hickory Grove

SUBDIVISION BLOCK / SECTION LOT LOT AREA 3.69 SITE CLASS. 5 DESIGN FLOW 360 L.T.A.R. 3

Septic Tank: 1000 Gallons: STB 1000 Date 7-14-06
Pump Tank: Gallons: PT Date
Pump Make: Model Serial No.
Nitrification Field: No Fields Square Feet 1200 Linear Feet 300
No Lines 3 Trench Width 36" Max Trench Bottom Depth 36" Gravel Depth NA

☑ New System ☐ Repair ☐ Expansion System Type: I (II) III IV V VI
System Description: 25% Graded
Repair System Description: 25% Existing
Maintenance Agreement Required: ☐ Yes ☐ No

☑ House/Mod. Home ☐ Mobile Home ☐ Business ☐ Other
No. Bedrooms 3 No. Persons No. Employees


Water Supply: ☑ Individual ☐ Public ☐ Community

☐ Gravity ☐ Pressure ☐ Slab ☑ Crawl Space ☐ Basement w/plumbing ☐ Basement wo/plumbing

Comments:/Conditions:
Install on Contour
Maintain all setbacks

Comments:/Conditions:
Distribution Box (3) speed levels
(Not to Scale)
Septic tank inlet
Bldg Label Line

INITIAL SITE SKETCH

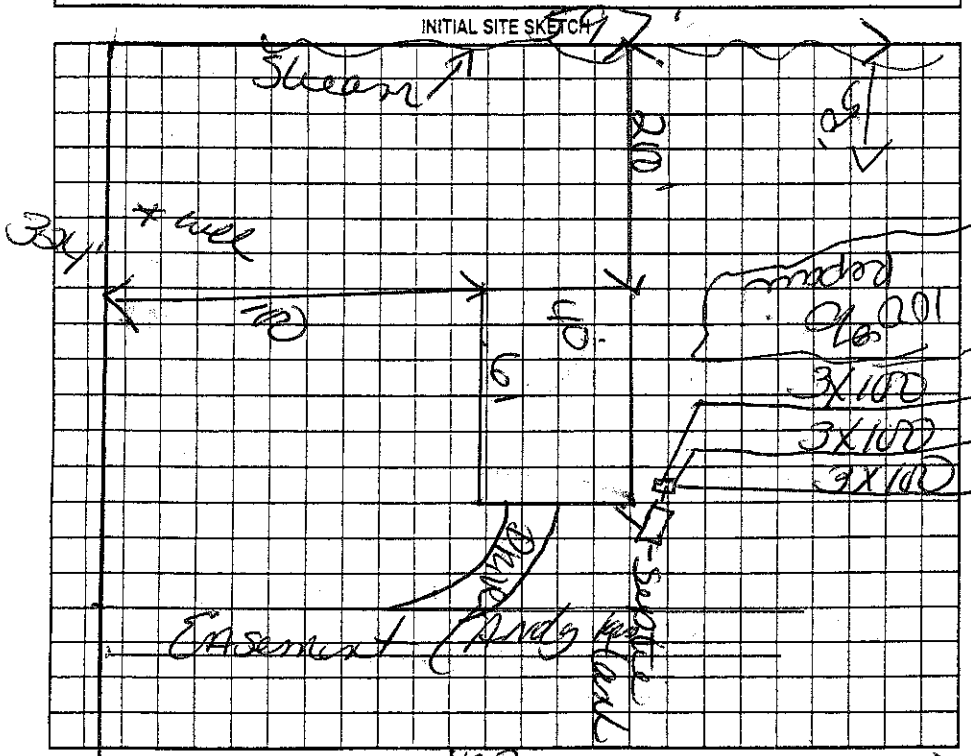

AS-BUILT SKETCH

Permit can be suspended or revoked if any false information is supplied toward securing the permit/any unauthorized changes are made to the site/any unauthorized changes are made in the installation of the system. Improvement Permit with plat valid without expiration ☐ Improvement Permit with site plan valid for sixty months ☐ Authorization to Construct is valid for a period equal to that of Improvement Permit – not to exceed sixty months.

Signed: date

Improvement Permit by: date 5-10-06

Authorization to Construct by: date 5-10-06

Installed by: date

Operation Permit by: date 9-5-06

Existing System Inspection by: date

HEALTH DEPT. COPY: WHITE OWNER COPY (FINAL): YELLOW OWNER COPY (INITIAL): PINK