2:00

IREDELL COUNTY HEALTH DEPARTMENT

STATESVILLE 704-878-5305 MOORESVILLE 704-664-5281

IMPROVEMENT PERMIT / AUTHORIZATION TO CONSTRUCT / OPERATION PERMIT / EXISTING SYSTEM INSPECTION

PERMIT # 149590 PIN # 3784-90-1303 DATE 7 August 09

OWNER or APPLICANT Martin Hendricks PHONE: Business (704) 902-0574 Home: (704) 872-5895

OWNER or APPLICANT ADDRESS 346 New Sterling Rd. Stony Point

LOCATION / DIRECTIONS Shannon School Rd. Turn onto Falling Creek - 2nd House on left.

SUBDIVISION Sharon Trace BLOCK / SECTION LOT # 38 LOT AREA 0.5Ac. DESIGN FLOW 360gpd. L.T.A.R. 0.3g/ft²d

Septic Tank 1000 Gallons: STB 1012 Date 4-15-08
Pump Tank Gallons: P T Date
Pump Make Model Serial #
Nitrification Field No Fields 1 No Lines 6 Linear Feet 300
Trench Width 36" Max. Trench Bottom Depth 36" Gravel Depth NA

☑ New System ☐ Repair ☐ Expansion System Type I II ○ IV V VI
System Description: 25% Reduction System
Repair System Description: 25% Reduction System
Maintenance Agreement Required ☐ YES ☑ NO
☑ GRAVITY ☐ PRESSURE

☑ Residence No. Bedrooms 3
☐ Business No. Persons
☐ Other No. Employees
☐ Slab ☑ Crawl Space
☐ Basement w/plumbing ☐ Basement w/o plumbing

Water Supply: ☐ Private ☑ Public ☐ Community

Comments / Conditions: Honor all setback requirements.

Comments / Conditions: Black Pike

INITIAL SITE SKETCH

N Please see Attached site sketch.

AS BUILT SKETCH

As shown on Diagram

Permit can be suspended or revoked if any false information is supplied toward securing the permit / any unauthorized changes are made to the site / any unauthorized changes are made in the installation of the system.

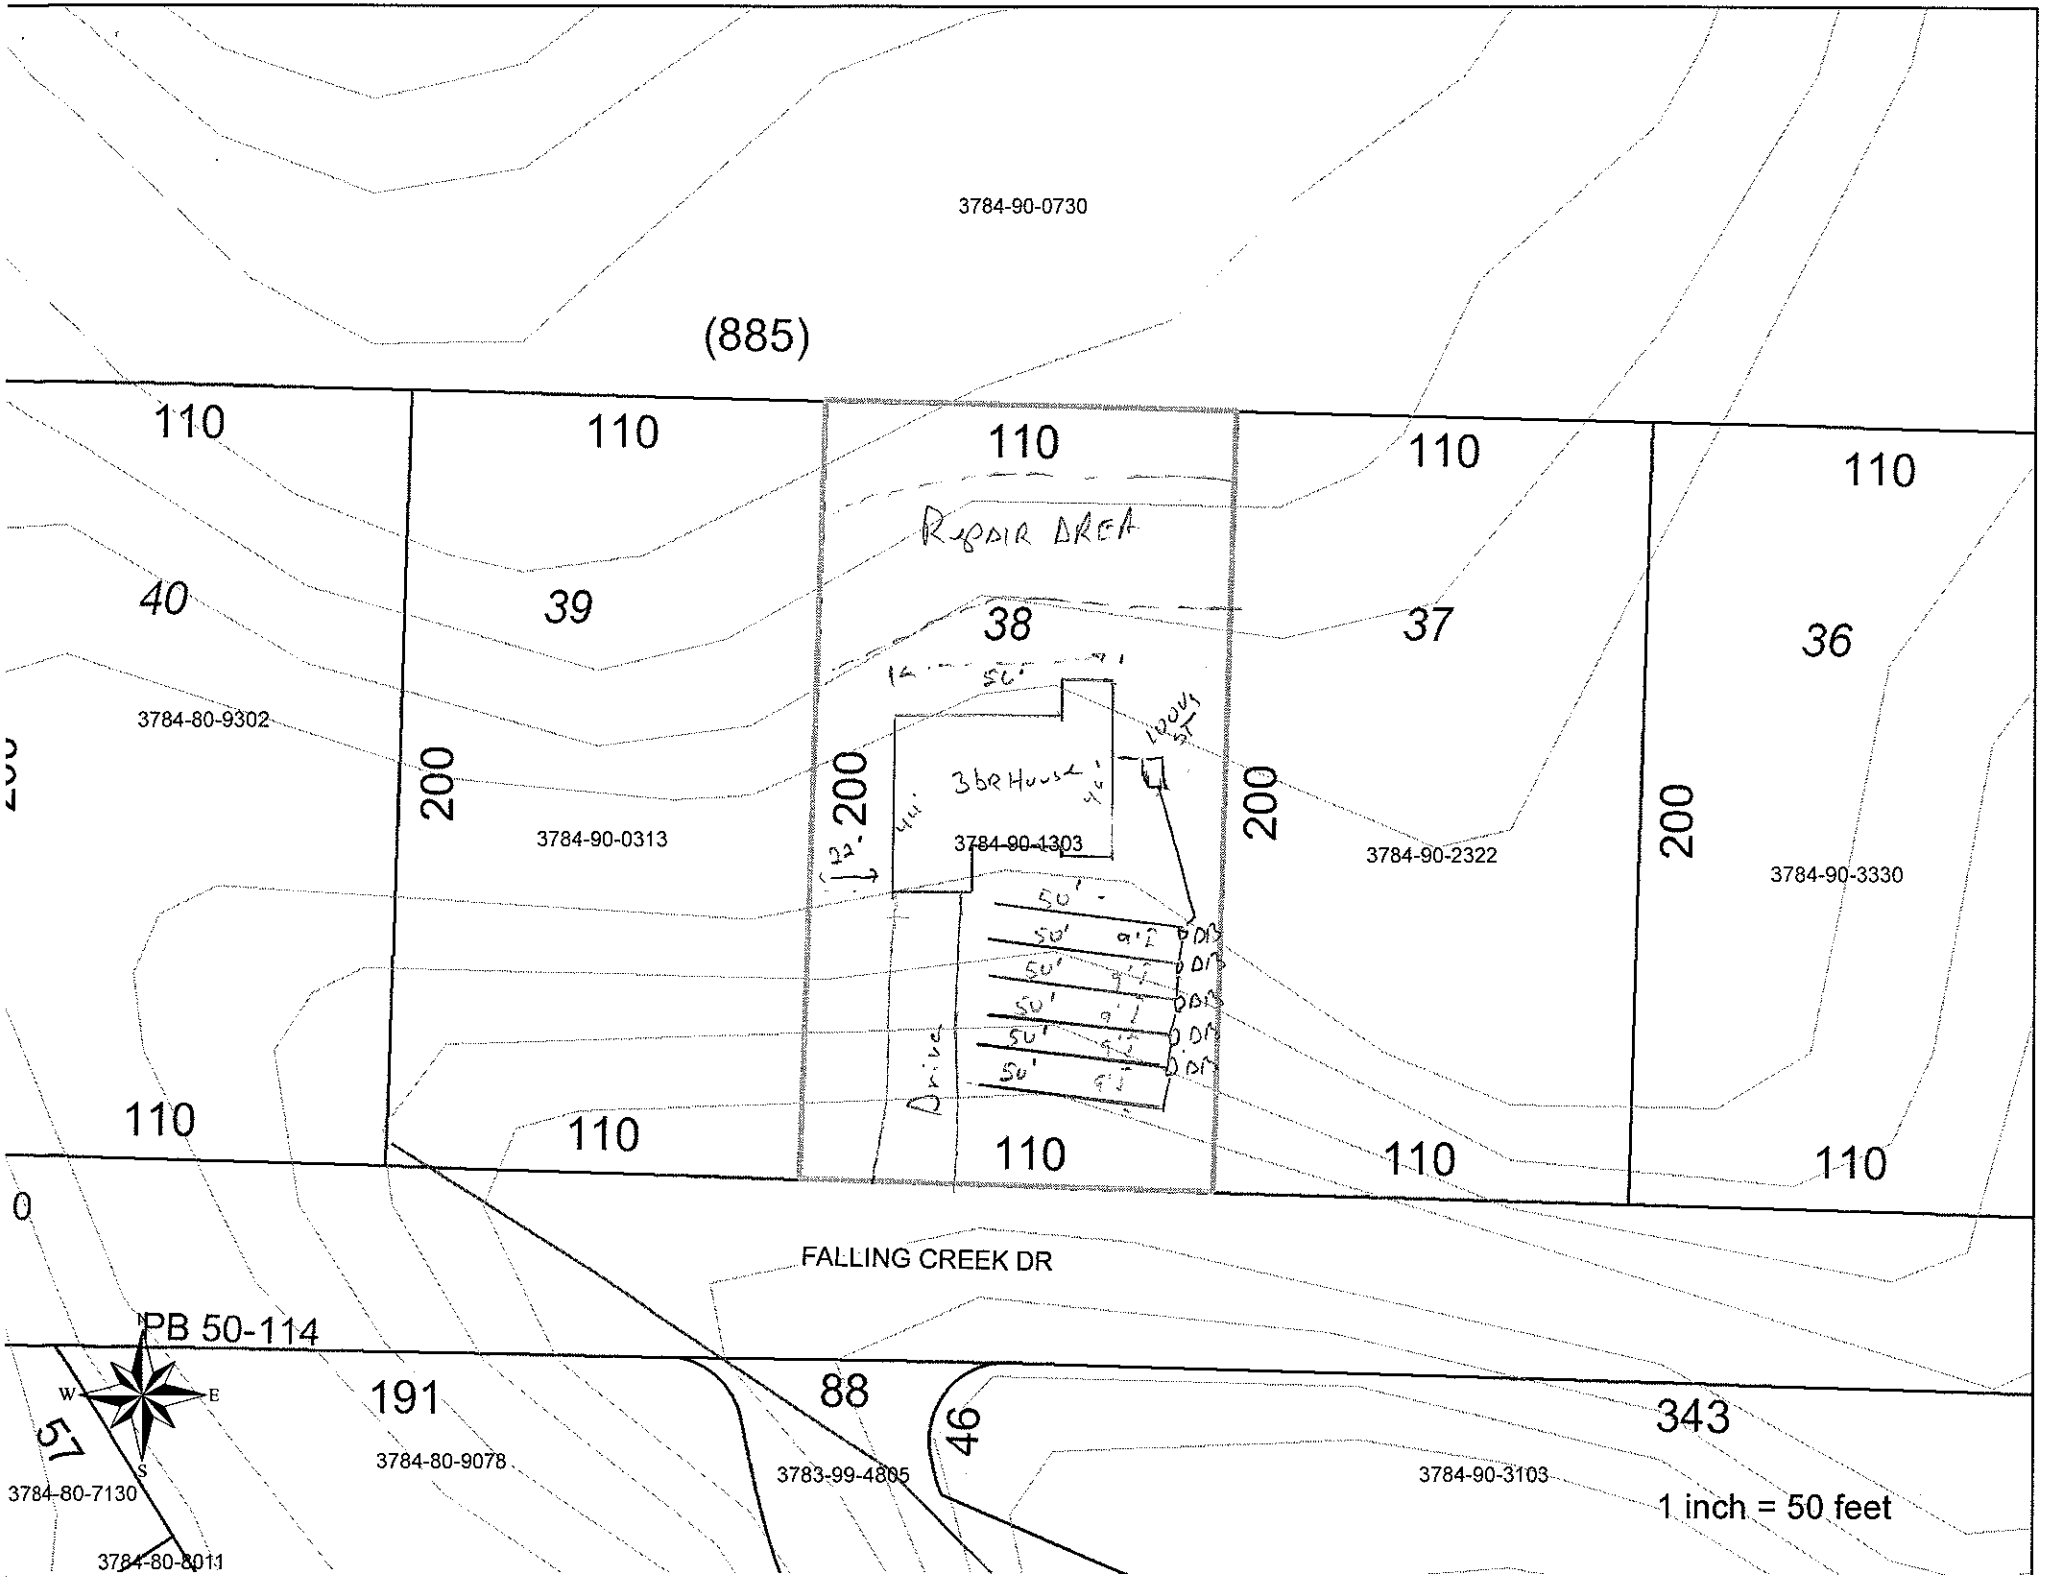
☐ *IMPROVEMENT PERMIT w / plat valid without expiration.* ☑ *IMPROVEMENT PERMIT w / site plan valid for 60 mos.* ☑ *AUTHORIZATION TO CONSTRUCT valid for period equal to IMPROVEMENT PERMIT-not to exceed 60 mo.*

Owner / Applicant Signature: Martin Hendricks Date 8-10-09
Improvement Permit by: [signature], R.S. Date 7 Aug. 09
Authorization to Construct by: [signature], R.S. Date 7 Aug. 09

Installed by: Craig Thompson
Operation Permit by: [signature] Date: 10-19-09
Existing System Inspected by: Date:

YOU SHOULD CONTACT A LOCATOR SERVICE PRIOR TO ANY EXCAVATION.

WHITE COPY Environmental Health YELLOW COPY (Final) Owner / Applicant PINK COPY (Initial) Owner / Applicant


3784-90-0730
(885)
110
110
110
110
110
110
Repair Area
40
39
38
37
36
3784-80-9302
3784-90-0313
3784-90-1303
3784-90-2322
3784-90-3330
200
200
200
200
3br House
Laundry
50'
50' 9'
50' 9'
50' 9'
50' 9'
50' 9'
Drive
110
110
110
110
110
110
FALLING CREEK DR
PB 50-114
191
88
343
46
57
3784-80-9078
3783-99-4805
3784-90-3103
3784-80-7130
3784-80-8011
1 inch = 50 feet