IREDELL COUNTY HEALTH DEPARTMENT

STATESVILLE 704-878-5305 MOORESVILLE 704-664-5281

IMPROVEMENT PERMIT / AUTHORIZATION TO CONSTRUCT / OPERATION PERMIT / EXISTING SYSTEM INSPECTION

PERMIT# 142605 PIN# 3784-90-5228 DATE 13 June 07

OWNER OR APPLICANT Scott Johnson PHONE: Business 704-528-1468 Home

ADDRESS 114 Cricket Ln. Statesville, N.C.

LOCATION Sharon School Rd. Turn Fallin Creek - Lots in left.

SUBDIVISION Sharon Trace BLOCK / SECTION 2 LOT 34 LOT AREA 0.5 Ac. SITE CLASS. PS DESIGN FLOW 360gpd L.T.A.R. 0.3g/ft²/d.

Septic Tank: 1000 Gallons; STB WP 6/18/07 Date 4-27-07

Pump Tank: Gallons; PT Date

Pump Make: Model Serial No.

Nitrification Field: No Fields 1 Square Feet = 1200 Linear Feet 300

No Lines 4 Trench Width 36" Max Trench Bottom Depth 36" Gravel Depth ☐ Gravity ☐ Pressure

☑ New System ☐ Repair ☐ Expansion System Type: I (II) III IV V VI

System Description: 25% Reduction

Repair System Description: 25% Reduction

Maintenance Agreement Required: ☐ Yes ☒ No

☒ House/Mod. Home No. Bedrooms 3

☐ Mobile Home No. Persons

☐ Business No. Employees

☐ Other

Water Supply: ☐ Individual ☒ Public ☐ Community

☐ Slab ☒ Crawl Space ☐ Basement w/plumbing ☐ Basement wo/plumbing

Comments:/Conditions:

Follow Contour

Comments:/Conditions:

INITIAL SITE SKETCH

See Attached Site Plan.

AS BUILT SKETCH

Installed As Drawn

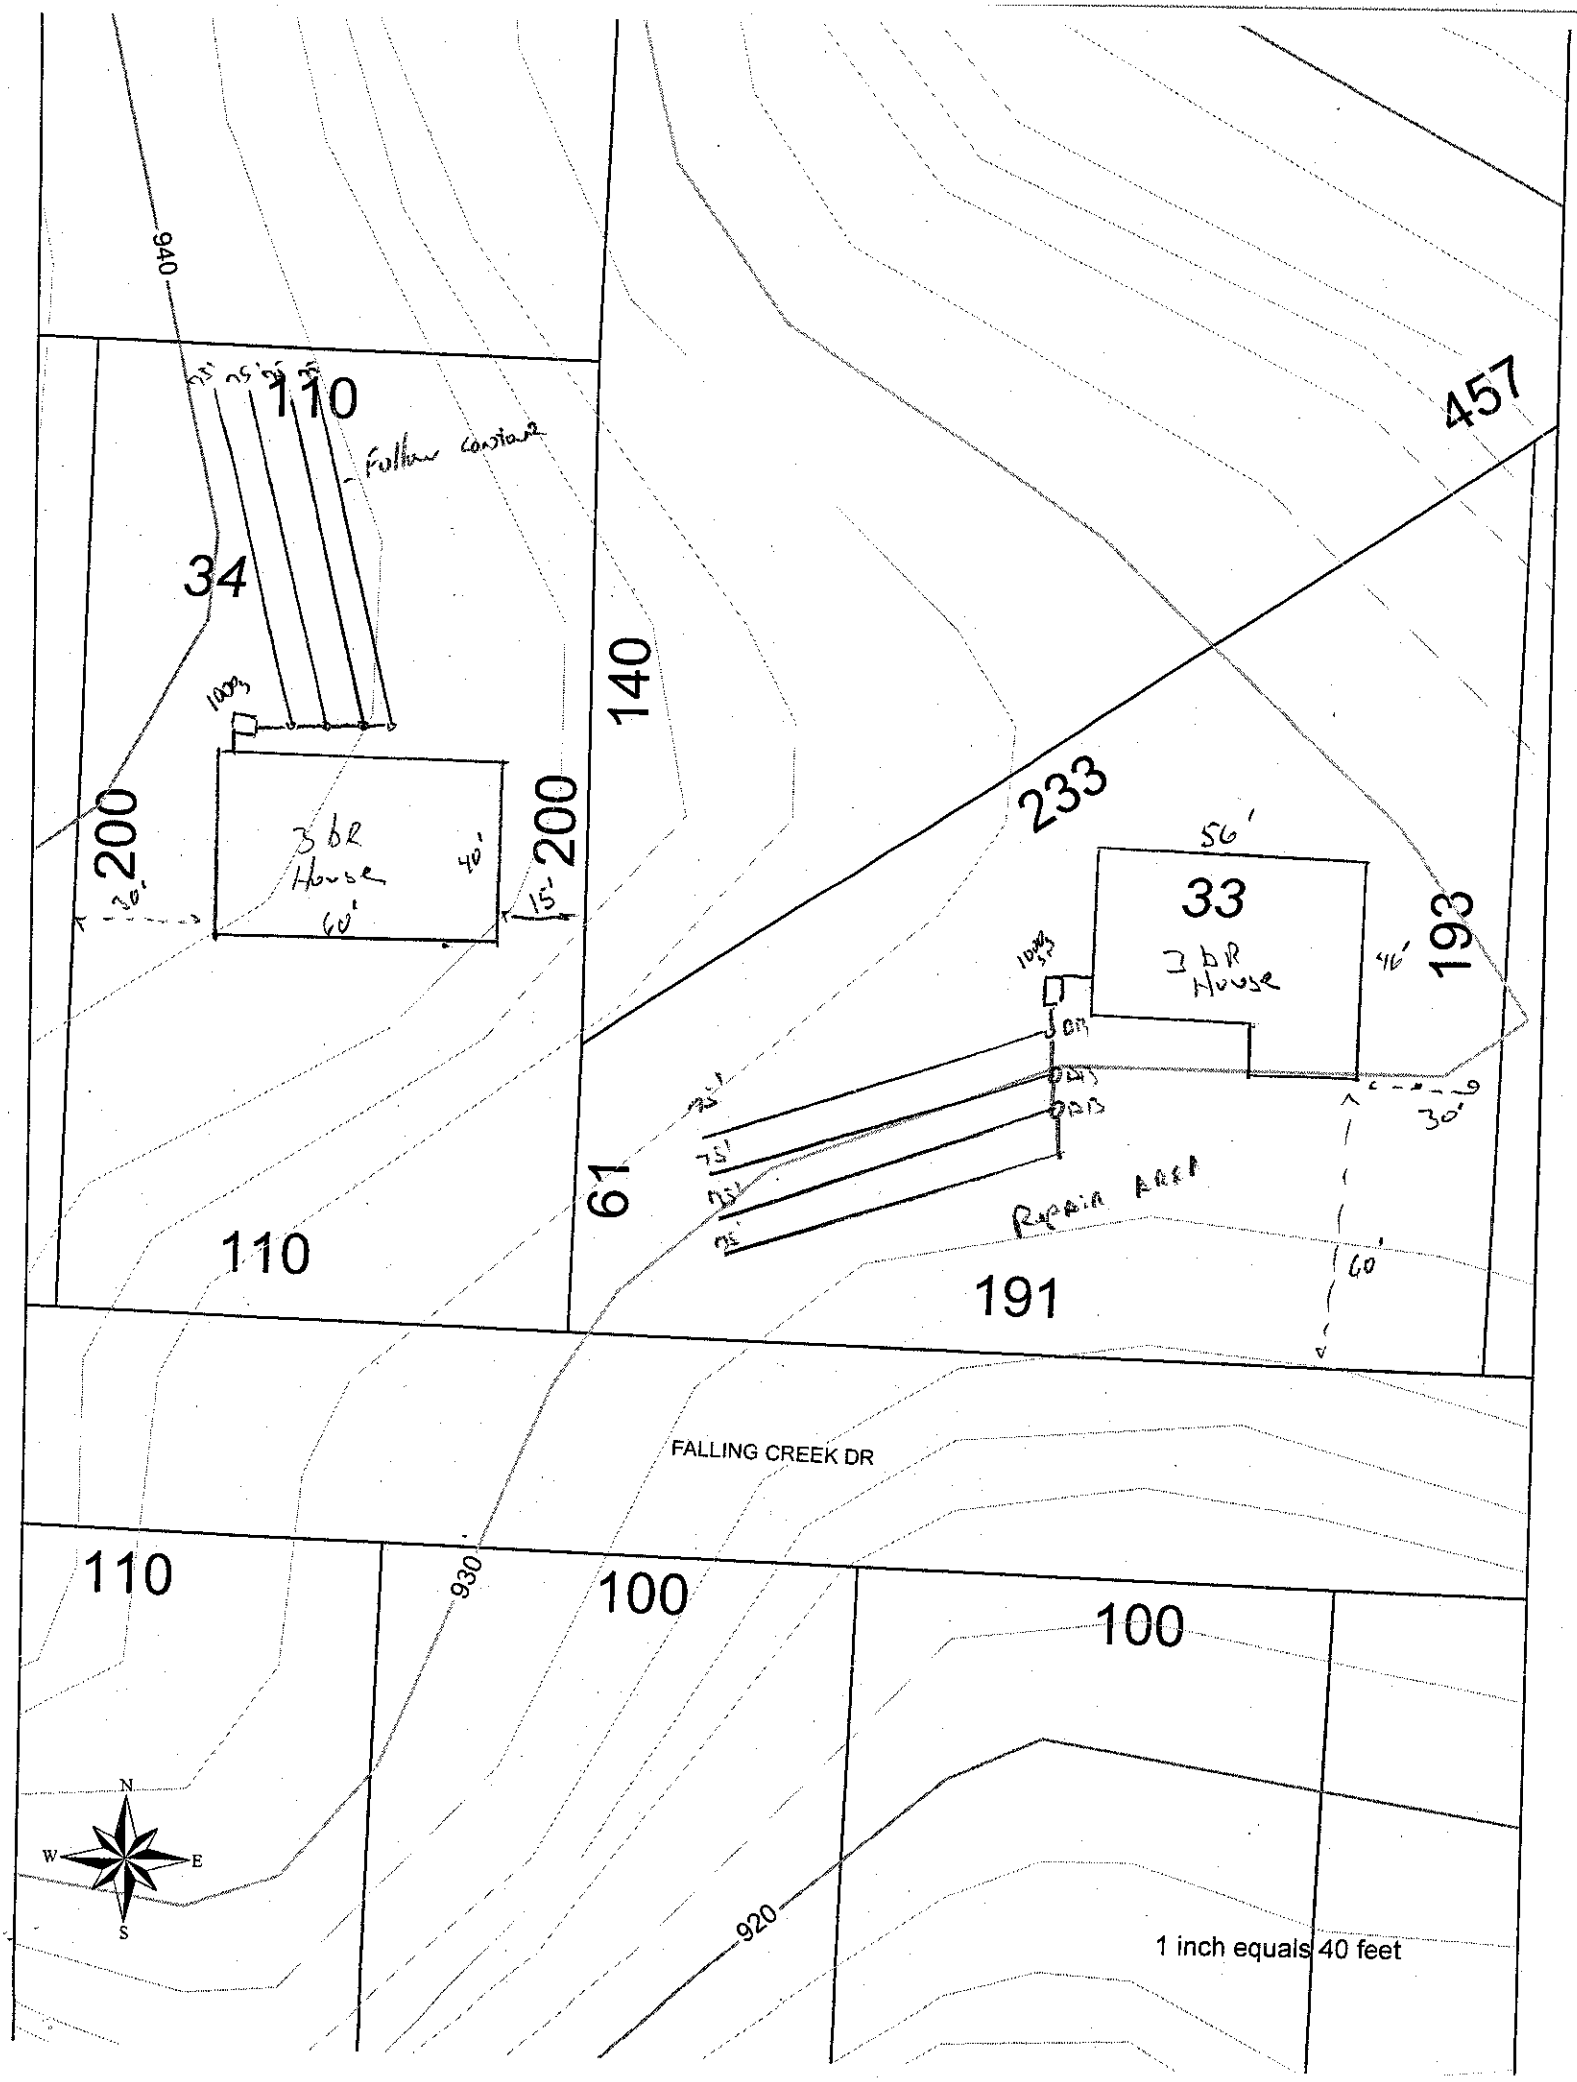
Permit can be suspended or revoked if any false information is supplied toward securing the permit/any unauthorized changes are made to the site/any unauthorized changes are made in the installation of the system. Improvement Permit with plat valid without expiration ☐ Improvement Permit with site plan valid for sixty months ☒ Authorization to Construct is valid for a period equal to that of Improvement Permit – not to exceed sixty months.

Signed: Scott K. Johnson date 6-26-07 Installed by: WES LYNN

Improvement Permit by: R.S. date 13 June 07 Operation Permit by: R.S. date 9-18-07

Authorization to Construct by: R.S. date 5 July 07 Existing System Inspection by: date

HEALTH DEPT. COPY: WHITE OWNER COPY (FINAL): YELLOW OWNER COPY (INITIAL): PINK


940
110
Follow contour
34
100g
3 bR House
40'
60'
30'
15'
200
200
140
457
233
56'
33
2 bR House
46'
193
100g
30'
Repair Area
60'
61
110
191
FALLING CREEK DR
110
930
100
100
920
N
W
E
S
1 inch equals 40 feet