IREDELL COUNTY HEALTH DEPARTMENT

THIS PERMIT VOIDS PREVIOUS ISSUED 7-22-03

STATESVILLE 704-878-5305 (cl) MOORESVILLE 704-664-5281

IMPROVEMENT PERMIT / AUTHORIZATION TO CONSTRUCT / OPERATION PERMIT / EXISTING SYSTEM INSPECTION

PERMIT# 113082 PIN# 3784-91-3188-1 3784-91-3294 DATE 8-18-03

OWNER OR CONTRACTOR DANA GAMBLE PHONE: Business 704-878-6711 Home 704-878-6005

ADDRESS 149 GREENWOOD DRIVE, STATESVILLE, NC 28625

LOCATION ISLAND FORD ROAD, TL GREENWOOD DRIVE, LOT ON LEFT AT 2ND CURVE

SUBDIVISION _____ BLOCK / SECTION _____ LOT 1 LOT AREA 1.104 ACRES SITE CLASS. PS DESIGN FLOW 360 L.T.A.R. EX. 0.33GPD/FT

Septic Tank: 1000 Gallons; STB 1012 Date 6-10-03
Pump Tank: 1000 Gallons; PT 17 Date 7-13-03
Pump Make: GOULDS Model WE05 11H Serial No. 903627 14
Nitrification Field: No Fields 1 Square Feet 690 Linear Feet 230
No Lines FIVE Trench Width 36" Max Trench Bottom Depth 36" Gravel Depth 12"

☑ New System ☐ Repair System Type: I, II, III, IV, V, VI
System Description: CONVENTIONAL PUMP FED
Repair System Description: CONVENTIONAL PUMP
Maintenance Agreement Required: ☐ Yes ☑ No


☑ House/Mod. Home No. Bedrooms 3
☐ Mobile Home No. Bathrooms 2
☐ Business No. Employees ____
☐ Other ____
☐ Slab ☑ Crawl Space ☑ Basement w/plumbing ☐ Basement wo/plumbing

Water Supply: ☑ Individual ☐ Public ☐ Community


Comments:/Conditions: EXCAVATE EXISTING DRAINLINES AT LOCATION SHOWN & FILL WITH CLAY. SEE ATTACHED SHEETS FOR PUMP ~~SYSTEM MANUFACTURER~~ REQUIREMENTS.

Comments:/Conditions: SEPTIC TANK WITH RISERS INSTALLED USING "TUFFITE" FILTER

INITIAL SITE SKETCH

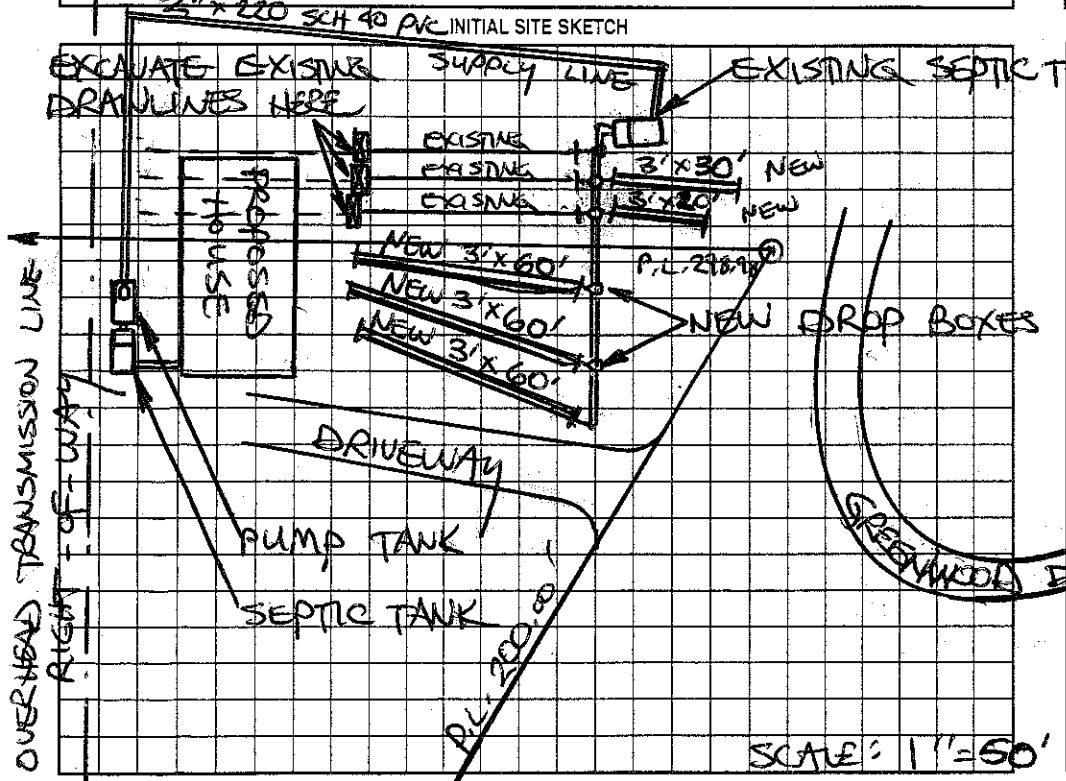

AS BUILT SKETCH

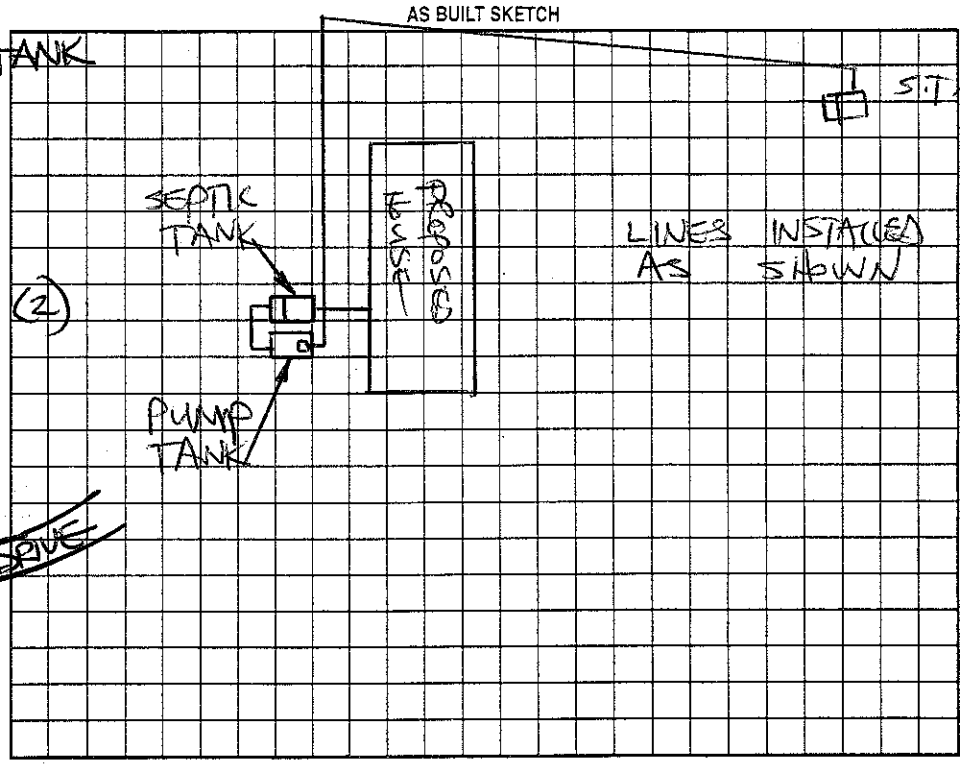

Permit can be suspended or revoked if any false information is supplied toward securing the permit/any unauthorized changes are made to the site/any unauthorized changes are made in the installation of the system. Improvement Permit with plat valid without expiration. Improvement Permit with site plan valid for sixty months. Authorization to Construct is valid for a period equal to that of Improvement Permit – not to exceed sixty months.

Signed: _____ date _____ Installed by: TOMMY FRYE

Improvement Permit by: STEVE HEDRICK date 8-18-03 Operation Permit by: STEVE HEDRICK date 12-31-03

P.L. - 204.38'

Authorization to Construct by: STEVE HEDRICK date 8-18-03 Existing System Inspection by: _____ date _____

HEALTH DEPT. COPY: WHITE OWNER COPY (FINAL): YELLOW OWNER COPY (INITIAL): PINK