IREDELL COUNTY HEALTH DEPARTMENT

STATESVILLE 704-878-5305 MOORESVILLE 704-664-3281

IMPROVEMENT PERMIT / CERTIFICATE OF COMPLETION / OPERATION PERMIT / EXISTING SYSTEM INSPECTION

PROPERTY DESCRIPTION NO. 20071 DATE 1-26-95 TAX MAP NO PI 4 87-1-126 Watershed ☐ Yes ☑ No

OWNER OR CONTRACTOR Davey Lester PHONE Business Home 835-1873

ADDRESS 816 Sharon Schnell Rd Statesville, N.C. 28677

LOCATION I-77 W T R Sharon School Rd TR Island Ford Rd TR First Driveway Past school House off rd on Rt (Tobacco MN)

SUBDIVISION N/A BLOCK/SECTION - LOT - LOT AREA Ample SITE CLASS PS DESIGN FLOW 360 LTAR .31gpd/ft²

Septic Tank 1000 Gallons SPT 1072 Date Rec'd 1-26-95 | New System ☐ Repair System Type CONVENTIONAL | House/Mod. Home No. Bedrooms 3 | Water Supply ☑ Individual

Pump Tank - Gallons PT - Date - | System Description Conventional, gravity fed | ☑ Mobile Home No. Bathrooms 2 | ☐ Community

Pump Make - Model - Serial No. - | Repair System Description - | ☐ Business No. Employees - | ☐ Public


Mlnkation Field: No. Lines 3 Square Feet 1050 Linear Feet 168' | Maintenance Agreement Required ☐ Yes ☑ No | ☐ Other

No. Lines 3 Trench Width 36" Max Trench Bottom Depth 36" | Gravel Depth 12" | ☐ Slab ☐ Crawl Space ☐ Basement w/plumbing ☐ Basement w/o plumbing


Comments: Install lines and trenches on curlew. Keep system 5' from foundation of home, 10' from all property lines, 50' from pond, out from underneath power line, back yard 65' from well. 100% Repair Area.

Comments: Home and well both located at time of inspection. Both are required distances from septic system.

INITIAL SITE SKETCH

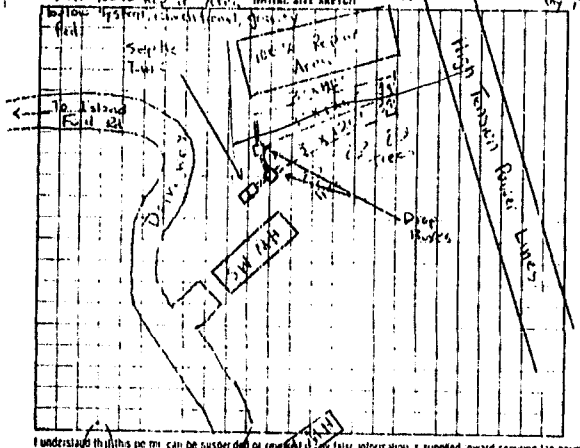

AS BUILT SKETCH

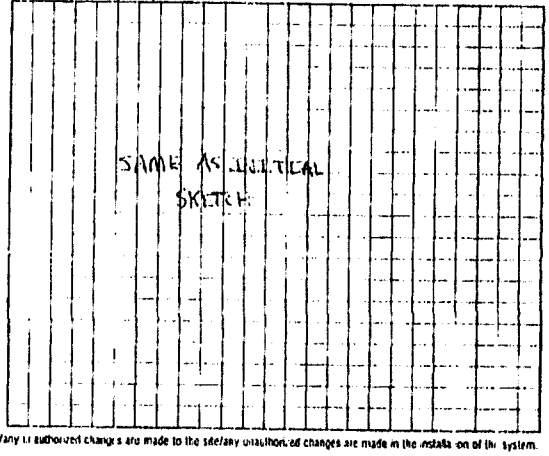

I understand that this permit can be suspended or revoked if any false information is supplied toward securing the permit any unauthorized changes are made to the site any unauthorized changes are made in the installation of the system. Improvement Permit is valid for 60 months from date of issuance

Signed [signature]

Improvement Permit by Michael J. Clemmons date 1-26-95

Existing System Inspection by ... date ...

Installed by Tommy Cothren

Certificate of Completion by Michael J. Clemmons date 2-2-95

Operation Permit by ... date ...

FEB. 27, 1989 16:37