IREDELL COUNTY HEALTH DEPARTMENT

STATESVILLE 704-878-5305 MOORESVILLE 704-664-5281

IMPROVEMENT PERMIT / AUTHORIZATION TO CONSTRUCT / OPERATION PERMIT / EXISTING SYSTEM INSPECTION

PERMIT# 73357 PIN# DATE 6-10-98

OWNER OR CONTRACTOR William Lee Kirksey, Jr. PHONE: Business Home 873 3362

ADDRESS 407 Shady Rest Rd Statesville, N.C.

LOCATION I-40 W TR / Sharon School TR Co. Line RD TR Bolick .3 mi left.

SUBDIVISION BLOCK / SECTION LOT LOT AREA 1 acre SITE CLASS. AS DESIGN FLOW 360 L.T.A.R. .33

Septic Tank: 1000 Gallons; STB 1000 Date 5-6-99
Pump Tank: Gallons; PT Date
Pump Make: Model Serial No
Nitrification Field: No Fields 1 Square Feet 1080 Linear Feet 360
No Lines 3 Trench Width 36" Max Trench Bottom Depth 36" Gravel Depth 12"

☑ New System ☐ Repair System Type: I, II, III, IV, V, VI
System Description: Conv. Gravity
Repair System Description:
Maintenance Agreement Required: ☐ Yes ☑ No

☐ House/Mod. Home ☑ Mobile Home ☐ Business ☐ Other
No. Bedrooms 3 No. Bathrooms 2 No. Employees

☑ Slab ☐ Crawl Space ☐ Basement w/plumbing ☐ Basement wo/plumbing


Water Supply: ☐ Individual ☐ Public ☐ Community

Comments:/Conditions:

209'

Comments:/Conditions:

INITIAL SITE SKETCH

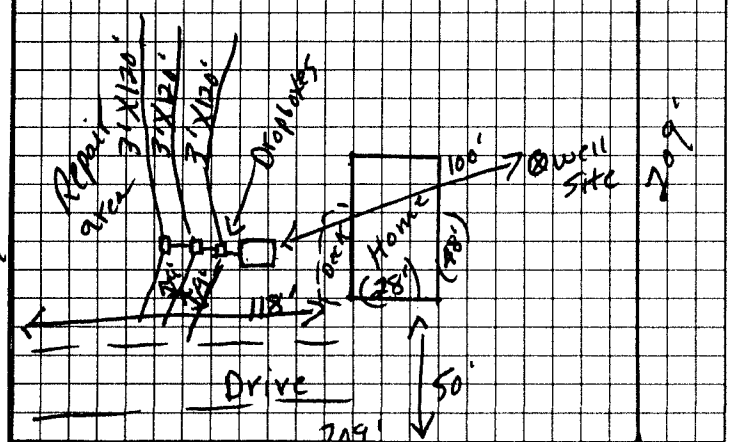

AS BUILT SKETCH

Same as initial sketch

I understand that this permit can be suspended or revoked if any false information is supplied toward securing the permit/any unauthorized changes are made to the site/any unauthorized changes are made in the installation of the system. Improvement Permit with plat valid without expiration. Improvement Permit with site plan valid for sixty months. Authorization to Construct is valid for a period equal to that of Improvement Permit – not to exceed sixty months.

Signed: x William L Kirksey Jr. date

Improvement Permit by: P.C. Moore date 6-10-98

Authorization to Construct by: P.C. Moore date 6-10-98

Installed by: Scott Greene

Operation Permit by: P.C. Moore date 7-16-99

Existing System Inspection by: date

HEALTH DEPT. COPY: WHITE INSPECTION COPY (FINAL): GREEN OWNER COPY (FINAL): YELLOW INSPECTION COPY (INITIAL): PINK OWNER COPY (INITIAL): GOLD