50147

IREDELL COUNTY HEALTH DEPARTMENT

STATESVILLE 704-878-5305 MOORESVILLE 704-664-5281

IMPROVEMENT PERMIT / CERTIFICATE OF COMPLETION / OPERATION PERMIT / EXISTING SYSTEM INSPECTION

PROPERTY DESCRIPTION NO. 13896 DATE 5-11-94 TAX MAP NO. 8V-A-58 Watershed: ☐ Yes ☑ No

OWNER OR CONTRACTOR Larry M. Beaver PHONE: Business _____ Home 873-5961

ADDRESS Rt. 16 Box 675 Statesville, N.C. 28677

LOCATION I40W TR old Mtn Rd. TL Pressly Farm Rd. on R past Taft Rd.

SUBDIVISION NA BLOCK / SECTION — LOT — LOT AREA Ample SITE CLASS P.S. DESIGN FLOW 360 L.T.A.R. 4 gpd/Ft²

Septic Tank: 1000 Gallons; STB 794 Date 3-16-94

Pump Tank: — Gallons; PT — Date —

Pump Make: — Model — Serial No. —

Nitrification Field: No Trenches 1 Square Feet 900 Linear Feet 300'

No Lines 3 Trench Width 36" Max Trench Bottom Depth 36" Gravel Depth 12"

☑ New System ☐ Repair System Type: I II III, IV, V, VI

System Description: conventional, gravity fed.

Repair System Description: Not permitted (1-10-92)

Maintenance Agreement Required: ☐ Yes ☑ No

☑ House/Mod. Home No. Bedrooms 3

☐ Mobile Home No. Bathrooms 2

☐ Business No. Employees _____

☐ Other _____

☐ Slab ☐ Crawl Space ☑ Basement w/plumbing ☐ Basement wo/plumbing


Water Supply: ☑ Individual ☐ Community ☐ Public

Comments:

Comments: 100% Repair Area not designated on Imp. Permit issued 1-10-92. Well not located at time of inspection, keep well min. 50' from any part of septic system.

INITIAL SITE SKETCH

AS BUILT SKETCH

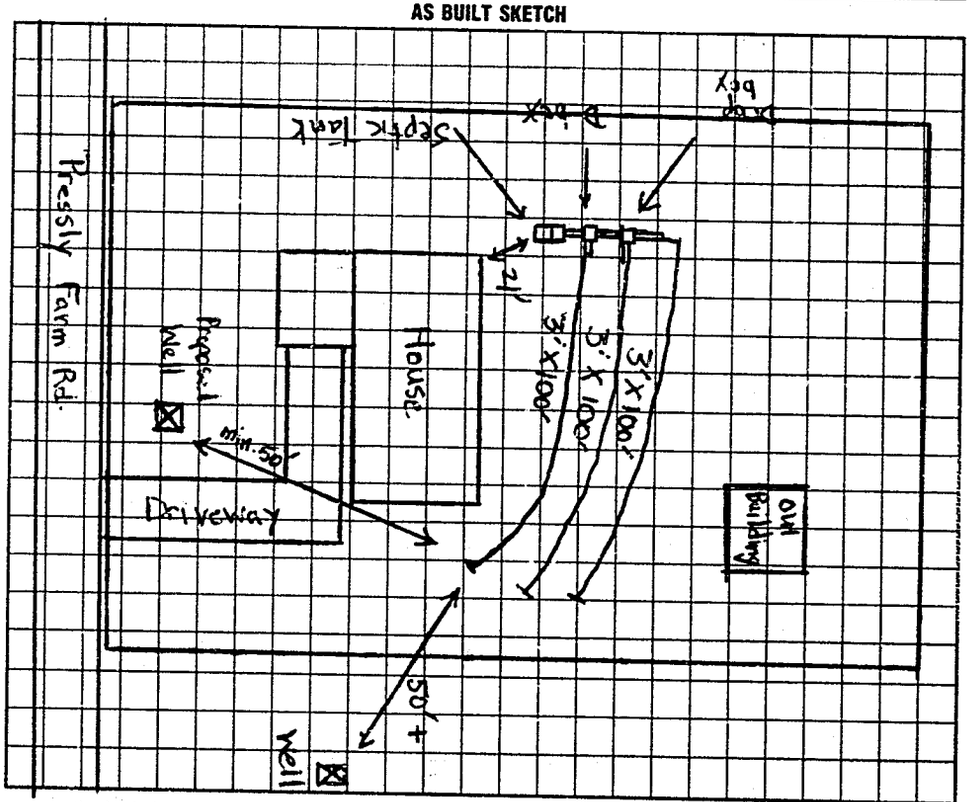

I understand that this permit can be suspended or revoked if any false information is supplied toward securing the permit/any unauthorized changes are made to the site/any unauthorized changes are made in the installation of the system. Improvement Permit is valid for 60 months from date of issuance.

Signed: _____

Improvement Permit by: Steve Brown date 1-10-92

Existing System Inspection by: _____ date _____

Installed by: A-1 Backhoe

Certificate of Completion by: Michael J. Dennis date 5-11-94

Operation Permit by: _____ date _____

HEALTH DEPT. COPY: WHITE INSPECTION COPY (FINAL): GREEN OWNER COPY (FINAL): YELLOW INSPECTION COPY (INITIAL): PINK OWNER COPY (INITIAL): GOLD