78338

IREDELL COUNTY HEALTH DEPARTMENT

AUTHORIZATION TO CONSTRUCT

STATESVILLE 704-878-5305 MOORESVILLE 704-664-5281

IMPROVEMENT PERMIT / ~~CERTIFICATE OF COMPLETION~~ / OPERATION PERMIT / EXISTING SYSTEM INSPECTION

PROPERTY DESCRIPTION NO. 26295 DATE 6/18/97 TAX MAP NO. 3985 69 7400 Watershed: ☑ Yes ☐ No

OWNER OR CONTRACTOR MICKEY HAGAR PHONE: Business Home

ADDRESS PO BOX 84 STONEY PT.

LOCATION OLD MT. RD - TL COUNTY LINE RD. ~ 1 MILE ON LEFT

SUBDIVISION VICTORIA'S LANDING BLOCK / SECTION LOT 2 LOT AREA 20460 SITE CLASS PS DESIGN FLOW 360GPD L.T.A.R. .3 GPD/LF

Septic Tank: 1000 Gallons; STB 1007 Date 10-21-98

Pump Tank: Gallons; PT Date

Pump Make: Model Serial No.

Nitrification Field: No Fields 1 Square Feet 1200 Linear Feet 400

No Lines 5@80' Trench Width 36" Max Trench Bottom Depth 36" Gravel Depth 12"

☑ New System ☐ Repair System Type: I (II) III, IV, V, VI

System Description: GRAVITY CONVENTIONAL

Repair System Description: PUMP/GRAVITY CONVENTIONAL

Maintenance Agreement Required: ☐ Yes ☐ No

☐ House/Mod. Home No. Bedrooms 3

☑ Mobile Home No. Bathrooms 2

☐ Business No. Employees

☐ Other


☐ Slab ☐ Crawl Space ☐ Basement w/plumbing ☐ Basement wo/plumbing

Water Supply: ☐ Individual ☐ Community ☑ Public


Comments: WELL ~~ACCEPT~~ ON LOT 3 MAY HAVE TO BE ABANDONED PROPERLY TO [redacted] OBTAIN 50' FROM SEPTIC SYSTEM.

Comments:

INITIAL SITE SKETCH 1"=40'

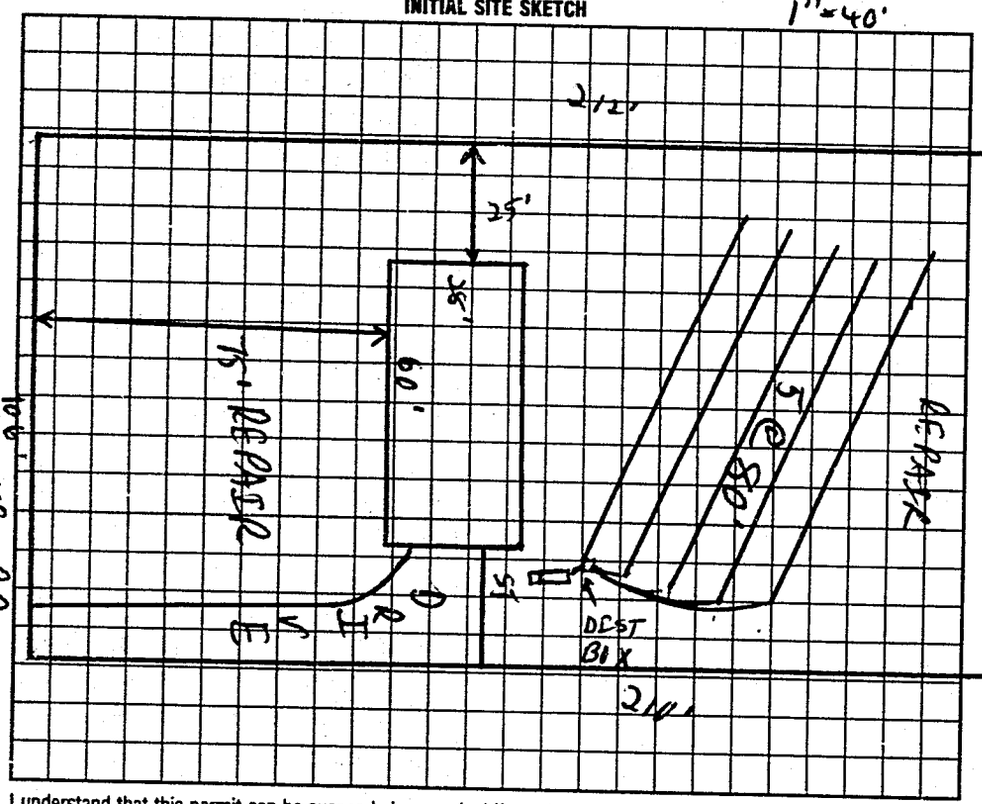

AS BUILT SKETCH

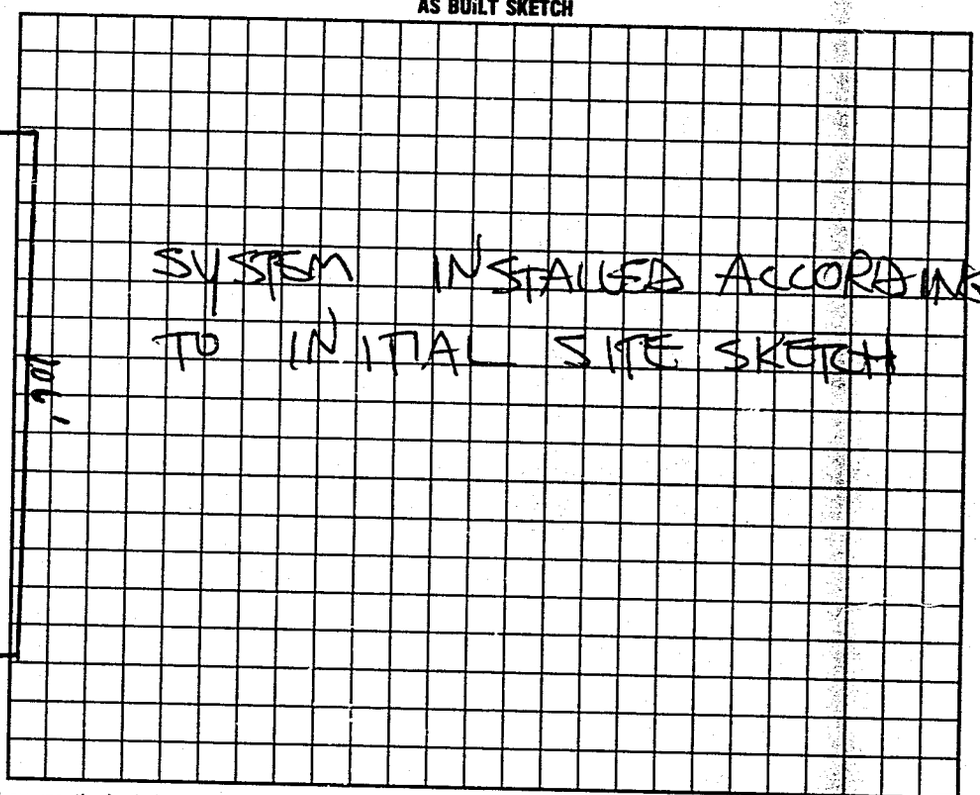

I understand that this permit can be suspended or revoked if any false information is supplied toward securing the permit/any unauthorized changes are made to the site/any unauthorized changes are made in the installation of the system. Improvement Permit is valid for 60 months from date of issuance.

Signed: Mickey Hagar

Improvement Permit by: C. Rob Freeman date 6/18/97

~~Existing System Inspection by:~~ AUTHORIZATION TO CONSTRUCT C. Rob Freeman date 6/18/97

Installed by: SCOTT GREENE

Certificate of Completion by: STEVE HEDRICK date 11-25-98

Operation Permit by: date

HEALTH DEPT. COPY: WHITE INSPECTION COPY (FINAL): GREEN OWNER COPY (FINAL): YELLOW INSPECTION COPY (INITIAL): PINK OWNER COPY (INITIAL): GOLD