IREDELL COUNTY HEALTH DEPARTMENT

STATESVILLE 704-878-5305 MOORESVILLE 704-664-5281

IMPROVEMENT PERMIT / AUTHORIZATION TO CONSTRUCT / OPERATION PERMIT / EXISTING SYSTEM INSPECTION

400

PERMIT# 075916 PIN# 3785 69 8398 DATE 8-20-98

OWNER OR CONTRACTOR JERRY L. HAGER, JR. PHONE: Business Home 585-6471

ADDRESS P.O. BOX 684, STONY POINT, NC 28678

LOCATION I-40 W, TR O.M.R, TL COUNTY LINE RD, TL, JORDAN CREST LANE, 2ND LOT ON RIGHT

SUBDIVISION VICTORIA'S LANDMARK BLOCK/ SECTION II LOT 133 LOT AREA 42,379 SF SITE CLASS. PS DESIGN FLOW 360 L.T.A.R. 0.30 SQ FT/FT²

Septic Tank: 1000 Gallons; STB 821 Date 3-1-98
Pump Tank: Gallons; PT Date
Pump Make: Model Serial No.
Nitrification Field: No Fields 1 Square Feet 1200 Linear Feet 400
No Lines THREE Trench Width 36" Max Trench Bottom Depth 36" Gravel Depth 12"

☑ New System ☐ Repair System Type: I, II, III, IV, V, VI
System Description: CONVENTIONAL GRAVITY
Repair System Description: CONV. GRAVITY
Maintenance Agreement Required: ☐ Yes ☑ No

☐ House/Mod. Home ☑ Mobile Home ☐ Business ☐ Other
No. Bedrooms 3 No. Bathrooms 2 No. Employees


☐ Slab ☑ Crawl Space ☐ Basement w/plumbing ☐ Basement wo/plumbing

Water Supply: ☐ Individual ☑ Public ☐ Community


Comments:/Conditions:

Comments:/Conditions:

INITIAL SITE SKETCH

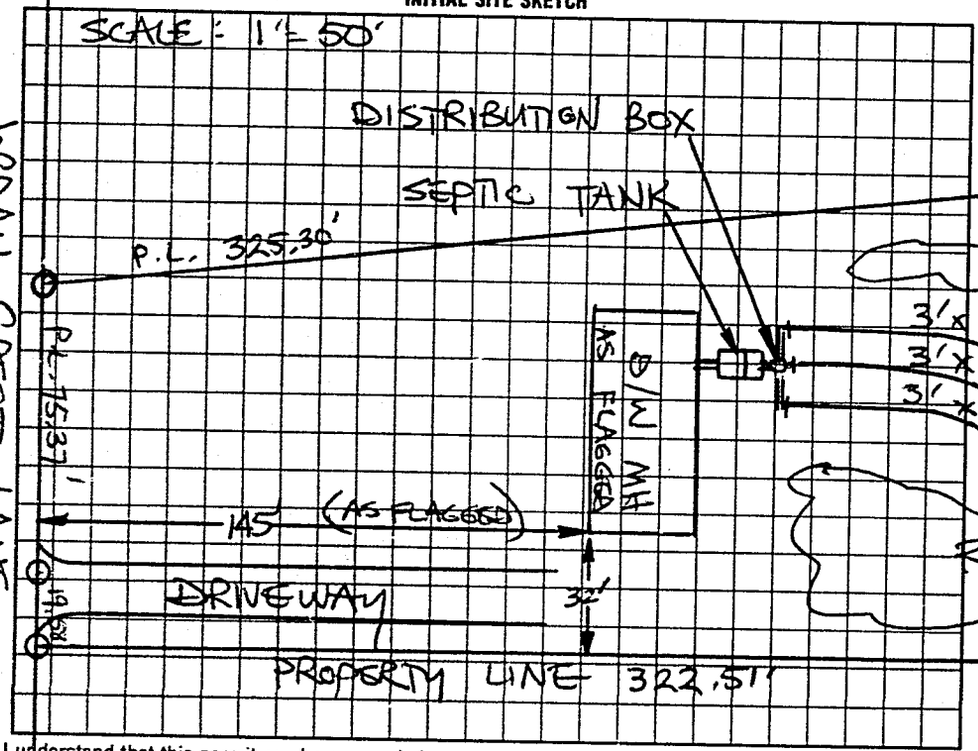

AS BUILT SKETCH

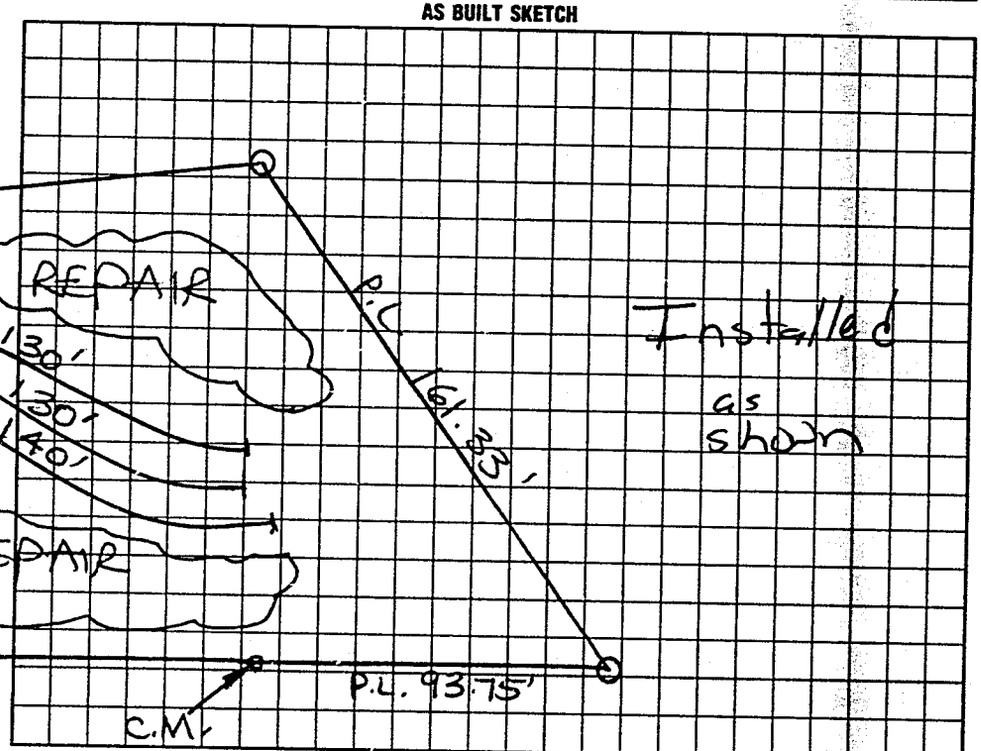

I understand that this permit can be suspended or revoked if any false information is supplied toward securing the permit/any unauthorized changes are made to the site/any unauthorized changes are made in the installation of the system. Improvement Permit with plat valid without expiration. Improvement Permit with site plan valid for sixty months. Authorization to Construct is valid for a period equal to that of Improvement Permit – not to exceed sixty months.

Signed: Jerry L Hager Jr date 8-20-98

Improvement Permit by: STEVE HEARICK date 8-20-98

Authorization to Construct by: STEVE HEARICK date 8-20-98

Installed by: Ace Trucking & Grading

Operation Permit by: Mark C Ojas date 8-24-98

Existing System Inspection by: date

HEALTH DEPT. COPY: WHITE INSPECTION COPY (FINAL): GREEN OWNER COPY (FINAL): YELLOW INSPECTION COPY (INITIAL): PINK OWNER COPY (INITIAL): GOLD