IREDELL COUNTY HEALTH DEPARTMENT

STATESVILLE 704-878-5305 MOORESVILLE 704-664-5281

IMPROVEMENT PERMIT / CERTIFICATE OF COMPLETION / OPERATION PERMIT / EXISTING SYSTEM INSPECTION

PROPERTY DESCRIPTION NO. 26296 ~~73496~~ DATE 11-7-97 TAX MAP NO. 3785 69 8617 Watershed: ☐ Yes ☐ No

OWNER OR CONTRACTOR JERRY HAGER PHONE: Business Home 585-6411

ADDRESS BOX 906 SMITH FARM ROAD, STONY POINT, NC 28678

LOCATION I-40 W TR O.M.R., TL COUNTY LINE ROAD, ~0.8 MILE ON LEFT AT JORDAN CREST RD.

SUBDIVISION VICTORIA'S LANDMARK SECTION LOT 4 LOT AREA 23,425 FT² SITE CLASS. PS DESIGN FLOW 360 L.T.A.R. 0.30 GPD/FT²

Septic Tank: 1000 Gallons; STB 160 Date 5-29-98

Pump Tank: Gallons; PT Date

Pump Make: Model Serial No.

Nitrification Field: No Fields 1 Square Feet 1200 Linear Feet 400

No Lines FIVE Trench Width 36" Max Trench Bottom Depth 36" Gravel Depth 12"

☑ New System ☐ Repair System Type: I, II, III, IV, V, VI

System Description: CONVENTIONAL GRAVITY

Repair System Description: CONV. GRAVITY

Maintenance Agreement Required: ☐ Yes ☐ No (ABANDON EXISTING SYSTEM)

☐ House/Mod. Home ☑ Mobile Home ☐ Business

No. Bedrooms 3 No. Bathrooms 2 No. Employees


☐ Slab ☑ Crawl Space ☐ Basement w/plumbing ☐ Basement wo/plumbing

Water Supply: ☐ Individual ☐ Community ☑ Public


Comments:

Comments:

INITIAL SITE SKETCH SCALE: 1" = 40'

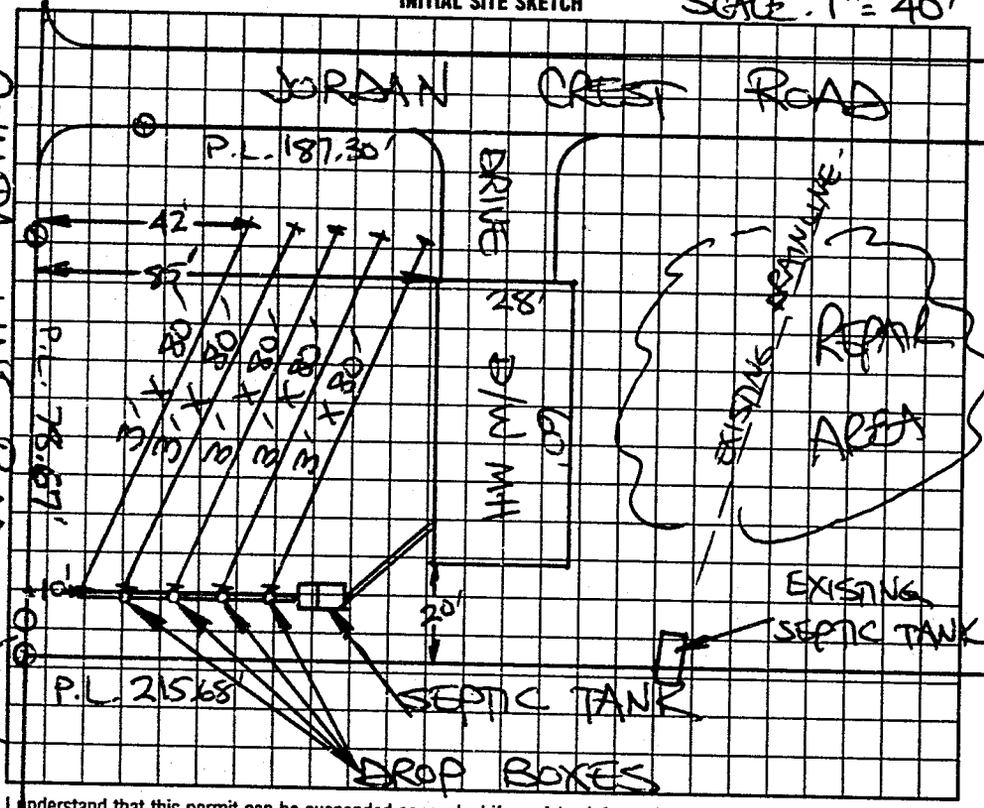

AS BUILT SKETCH

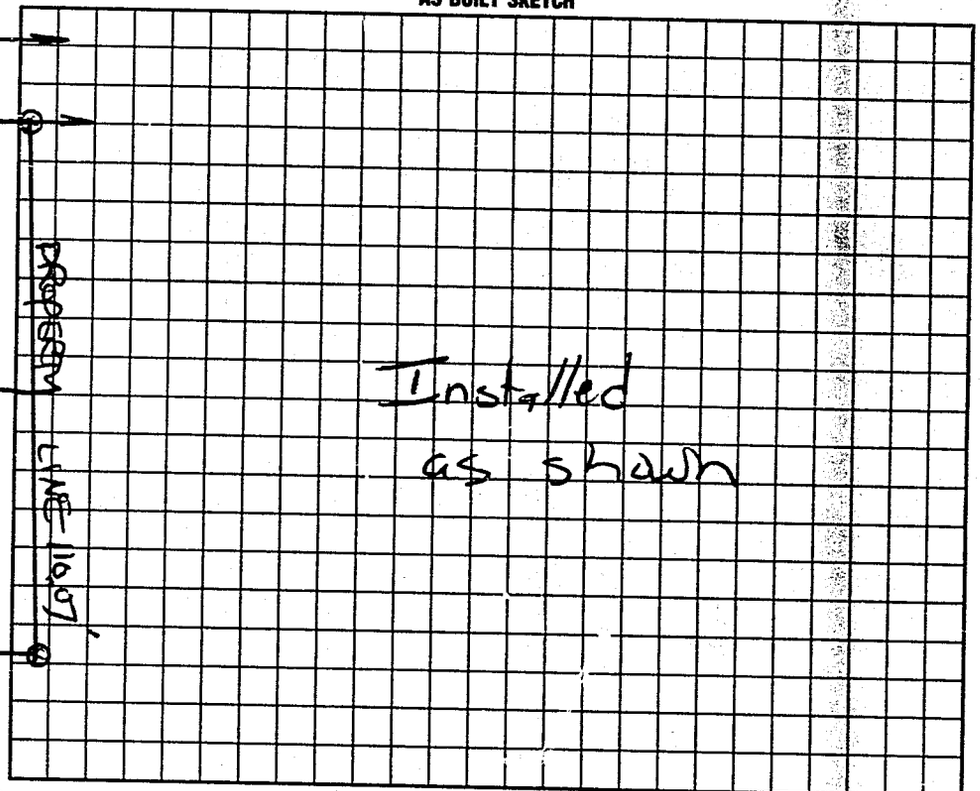

I understand that this permit can be suspended or revoked if any false information is supplied toward securing the permit/any unauthorized changes are made to the site/any unauthorized changes are made in the installation of the system. Improvement Permit is valid for 60 months from date of issuance. AUTHORIZATION TO CONSTRUCT IS VALID FOR 60 MONTHS FROM DATE OF ISSUANCE.

Signed: [signature]

Improvement Permit by: STEVE HENDRICK date 11-7-97

AMEND TO CONST Existing System Inspection by: STEVE HENDRICK date 11-7-97

Installed by: Shane Jarrett

Certificate of Completion by: date

Operation Permit by: Mark C. Ortz RS date 7-17-98

HEALTH DEPT. COPY: WHITE INSPECTION COPY (FINAL): GREEN OWNER COPY (FINAL): YELLOW INSPECTION COPY (INITIAL): PINK OWNER COPY (INITIAL): GOLD