IREDELL COUNTY HEALTH DEPARTMENT

STATESVILLE 704-878-5305 MOORESVILLE 704-664-5281

IMPROVEMENT PERMIT / AUTHORIZATION TO CONSTRUCT / OPERATION PERMIT / EXISTING SYSTEM INSPECTION

DATE June 1, 2000

PERMIT# 089430 PIN# 3785699396

OWNER OR CONTRACTOR Robert McElroy PHONE: Business 585-9886 Home

ADDRESS P.O. Box 605 Stony Point 28678

LOCATION Old Mtn Road TL County Line Rd. 1.1 miles TL Jordan Crest Ln. 3rd lot on Right

SUBDIVISION Victorias Landmark BLOCK / SECTION 2 LOT 32 LOT AREA .79 Ac SITE CLASS PS DESIGN FLOW 360gpd L.T.A.R. .83

Septic Tank: 1000 Gallons; STB 1012 Date 2/3/00

Pump Tank: Gallons; PT Date

Pump Make: Model Serial No.

Nitrification Field: No Fields 1 Square Feet 1200 Linear Feet 400

No Lines 4 Trench Width 36" Max Trench Bottom Depth 36"

☑ New System ☐ Repair System Type: I II III IV V VI

System Description: Gravity Conventional

Repair System Description Gravity pumped Innovative

Maintenance Agreement Required ☐ Yes ☑ No

Gravel Depth 12"

☐ House/Mod. Home ☑ Mobile Home ☐ Business ☐ Other

No. Bedrooms 3 No. Bathrooms 2 No. Employees


Water Supply: ☐ Individual ☑ Public ☐ Community

☐ Slab ☑ Crawl Space ☐ Basement w/plumbing ☐ Basement wo/plumbing


Comments/Conditions: Installer note: Laterals should be installed from 30-36" trench bottom depth.

Comments/Conditions: Mid line, All 4 Lines, A cap of fill. Rock-Brick Dirt + Tubes

INITIAL SITE SKETCH

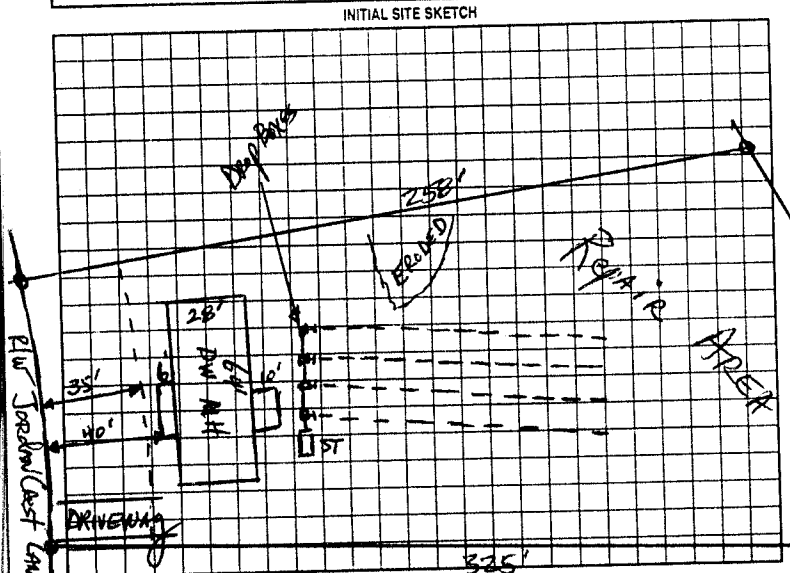

AS BUILT SKETCH

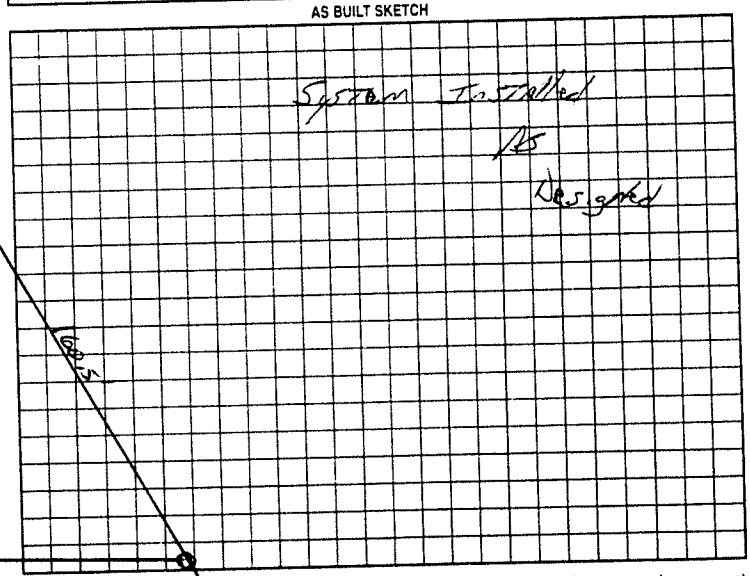

Permit can be suspended or revoked if any false information is supplied toward securing the permit/any unauthorized changes are made to the site/any unauthorized changes are made in the installation of the system. Improvement Permit with plat valid without expiration. Improvement Permit with site plan valid for sixty months. Authorization to Construct is valid for a period equal to that of Improvement Permit – not to exceed sixty months.

Signed: Ken Walter date 6/5/00

Improvement Permit by: Mark Johnson, RS date 6-1-00

Authorization to Construct by: Mark Johnson, RS date 6-1-00

Installed by: Craig Thompson

Operation Permit by: Joe Baker date June 12 2000

Existing System Inspection by: date

HEALTH DEPT. COPY: WHITE OWNER COPY (FINAL): YELLOW OWNER COPY (INITIAL): PINK