IREDELL COUNTY HEALTH DEPARTMENT

AUTHORIZATION TO CONSTRUCT

STATESVILLE 704-878-5305 MOORESVILLE 704-664-5281

IMPROVEMENT PERMIT / ~~CERTIFICATE OF COMPLETION~~ / OPERATION PERMIT / EXISTING SYSTEM INSPECTION

PROPERTY DESCRIPTION NO. 26297 DATE 6/18/97 TAX MAP NO. 3985699702 Watershed: ☒ Yes ☐ No

OWNER OR CONTRACTOR MICKEY HAGAR PHONE: Business Home —

ADDRESS PO BOX 684 STONEY PT NC 28678

LOCATION OLD MT. RD - TL COUNTY LINE RD - ON LEFT ~ 1 MILE

SUBDIVISION VICDREA'S LANDMARK BLOCK / SECTION LOT 5 LOT AREA 22830 SITE CLASS. RS DESIGN FLOW 360 GPD L.T.A.R. .36 GPD/FT²

Septic Tank: 1000 Gallons; STB Date 6-9-97

Pump Tank: Gallons; PT Date

Pump Make: Model Serial No.

Nitrification Field: No Fields 1 Square Feet 900 Linear Feet 300

No Lines 4@75 Trench Width 36" Max Trench Bottom Depth 36" Gravel Depth N/A

☒ New System ☐ Repair System Type: I, II, III, IV, V, VI

System Description: GRAVITY CHAMBERED ORSENEER

Repair System Description: PUMP CHAMBERED ORSENEER

Maintenance Agreement Required: ☐ Yes ☒ No

☐ House/Mod. Home ☒ Mobile Home ☐ Business ☐ Other

No. Bedrooms 3 No. Bathrooms 2 No. Employees


☐ Slab ☒ Crawl Space ☐ Basement w/plumbing ☐ Basement wo/plumbing

Water Supply: ☐ Individual ☐ Community ☒ Public


Comments:

Comments:
Note; Tank turned 90° from original location - lines feed by drop boxes

INITIAL SITE SKETCH 1"=40'

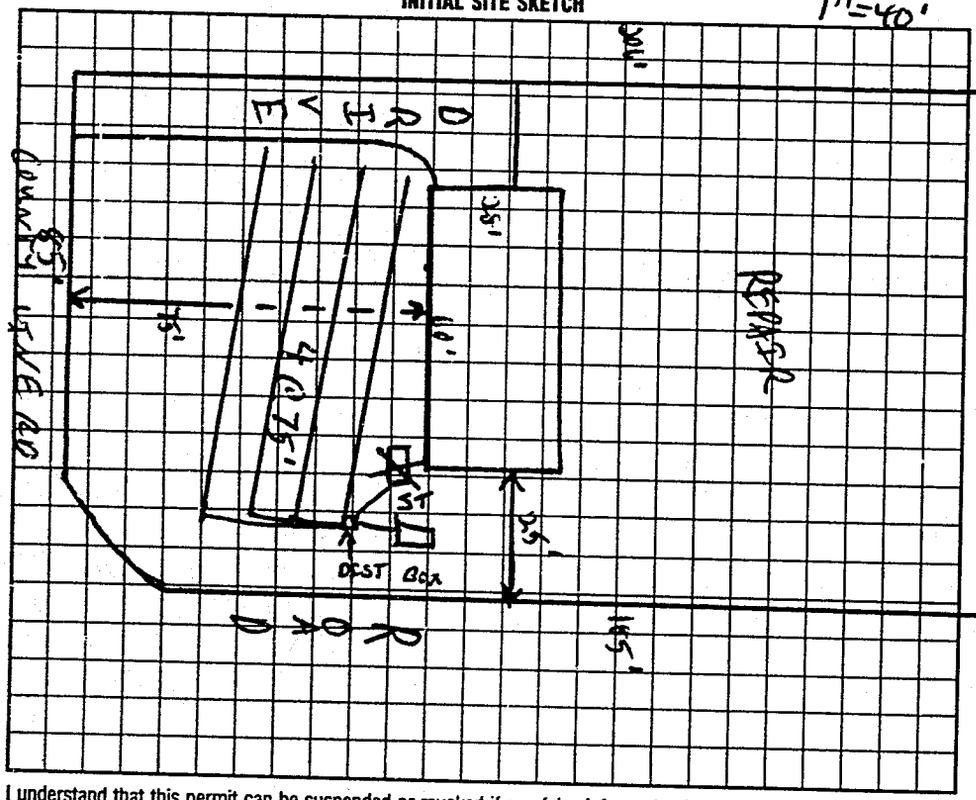

AS BUILT SKETCH

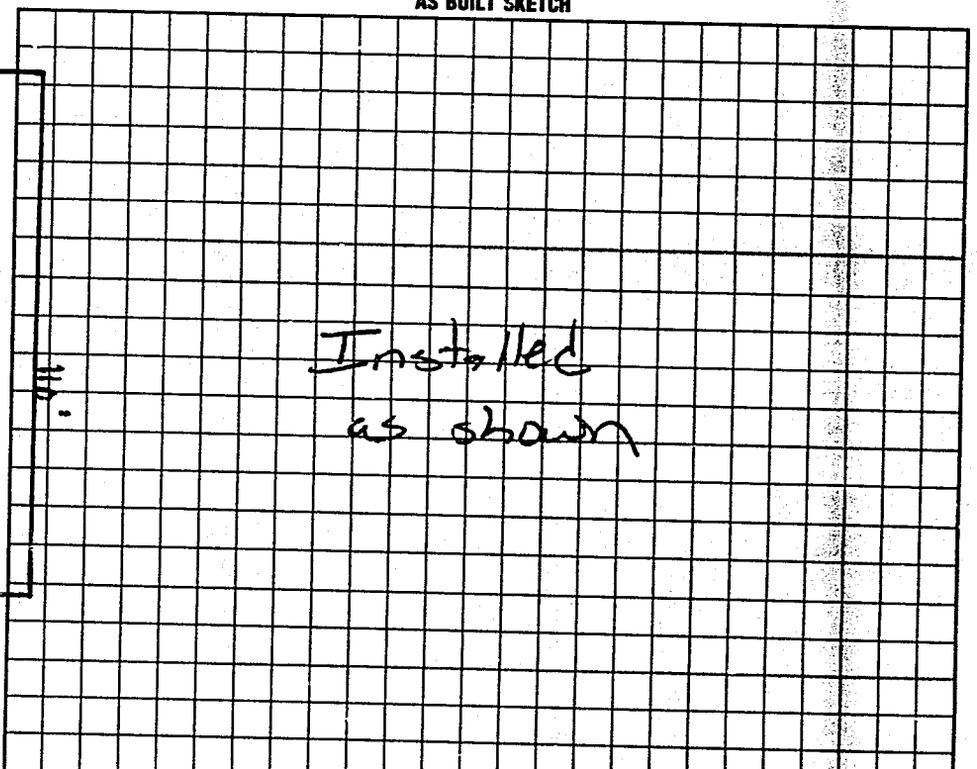

I understand that this permit can be suspended or revoked if any false information is supplied toward securing the permit/any unauthorized changes are made to the site/any unauthorized changes are made in the installation of the system. Improvement Permit is valid for 60 months from date of issuance.

Signed: Mickey Hagar

Improvement Permit by: C. Ray Stevens date 6/18/97

~~Existing System Inspection by:~~ AUTHORIZATION TO CONSTRUCT C. Ray Stevens date 6/18/97

Installed by: Shane Jarrett

~~Certificate of Completion by:~~ date

Operation Permit by: Matt Cook RS date 7-20-98

HEALTH DEPT. COPY: WHITE INSPECTION COPY (FINAL): GREEN OWNER COPY (FINAL): YELLOW INSPECTION COPY (INITIAL): PINK OWNER COPY (INITIAL): GOLD