IREDELL COUNTY HEALTH DEPARTMENT

Statesville Phone TR 3-7271 Mooresville Phone NO 3-1271

PERMIT TO INSTALL SEPTIC TANK

Permit NO. _____ Permit Date Jan 13 1965

Owner J C Dagenhart Address R 8

Installed By C Hoke Address R 7


Location of Property Out 1005 To 1534 ~~Bradley~~ Pressly Farm Rd. left at barn Pressly's at end of Rd

Tank		Capacity		Length of Lines		Fixtures	
Block	( )	800	( )	150'	( )	No. of Baths	( )
Precast	(✓)	900	( )	175'	( )	Dishwasher	( )
		1000	(✓)	200'	( )	Garbage Grdr.	( )
		1100	( )	225'	(✓)	Auto-Washer	( )
		1200	( )	250'	( )	Other Trailer	
		Other _____		Other _____			

NOTIFY HEALTH DEPARTMENT AT LEAST EIGHT HOURS BEFORE TANK IS TO BE INSPECTED.

Final Inspection 1-13 1965 Approved (✓) Disapproved ( )

Remarks Wooded No well this date

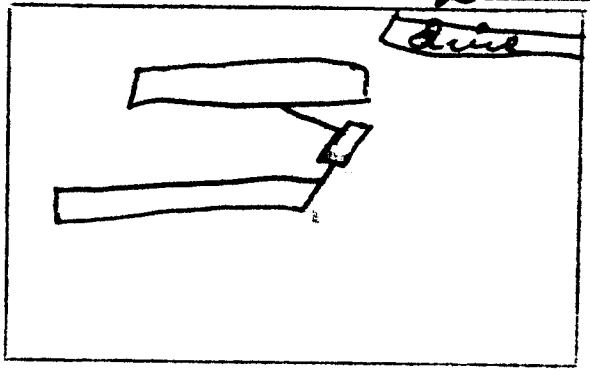

Sketch of Installation

Rd.

Sanitarian