IREDELL COUNTY HEALTH DEPARTMENT

STATESVILLE 704-878-5305 MOORESVILLE 704-664-5281

IMPROVEMENT PERMIT / AUTHORIZATION TO CONSTRUCT / OPERATION PERMIT / EXISTING SYSTEM INSPECTION

PERMIT# 87510 PIN# 3748722310 DATE Feb 7-2000

OWNER OR CONTRACTOR William GRANT PHONE: Business 87 Home 872-8310

ADDRESS 171 JAMIE DR STATESVILLE NC

LOCATION Old MT Rd N/th (L) County Line (L) Jordan Crest 2nd Lot on Left 115 Jordan Crest Lane

SUBDIVISION Victoria Landmark BLOCK / SECTION 2 LOT 8 LOT AREA .63 SITE CLASS PS DESIGN FLOW 360 L.T.A.R.

Septic Tank: 1000 Gallons; STB 1012 Date 10 17 99
Pump Tank: Gallons; PT Date
Pump Make: Model Serial No.
Nitrification Field: No Fields 1 Square Feet 1200 Linear Feet 400
No Lines 4 Trench Width 36" Max Trench Bottom Depth 36 40 Gravel Depth 12"

☒ New System ☐ Repair System Type: I. ☒ II. III. IV. V. VI
System Description: Conv. GRAVITY
Repair System Description: 25% Red. Prop Poss. Lk
Maintenance Agreement Required: ☐ Yes ☒ No


☐ House/Mod. Home ☒ Mobile Home ☐ Business ☐ Other
No. Bedrooms 3 No. Bathrooms 2 No. Employees
☐ Slab ☒ Crawl Space ☐ Basement w/plumbing ☐ Basement wo/plumbing

Water Supply: ☐ Individual ☒ Public ☐ Community


Comments/Conditions: DISTRIBUTION BOX W/ Speed Levels

Comments/Conditions

INITIAL SITE SKETCH

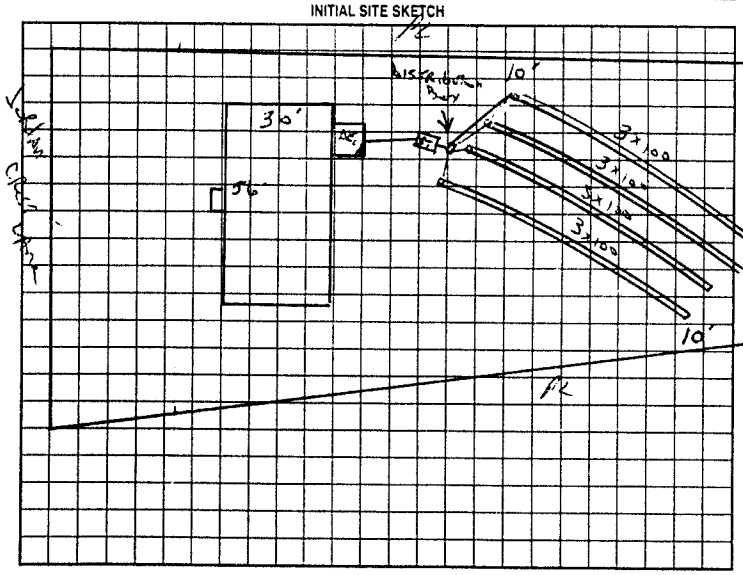

AS BUILT SKETCH

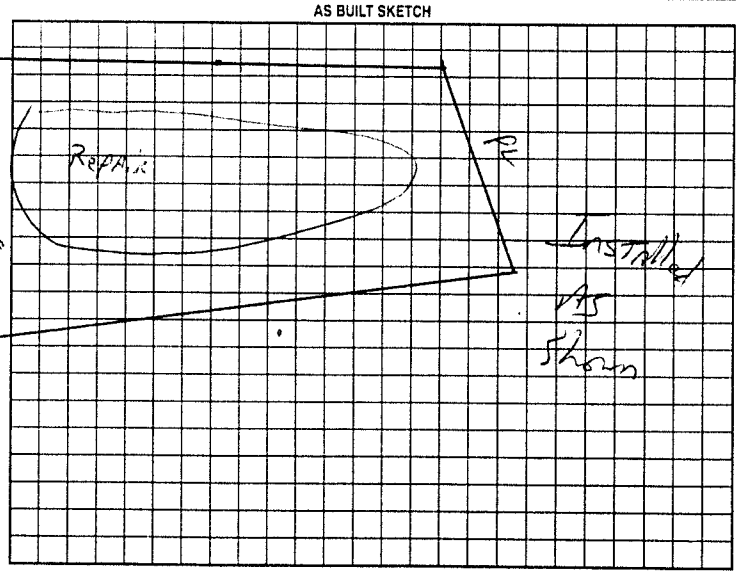

Permit can be suspended or revoked if any false information is supplied toward securing the permit/any unauthorized changes are made to the site/any unauthorized changes are made in the installation of the system. Improvement Permit with plat valid without expiration. Improvement Permit with site plan valid for sixty months. Authorization to Construct is valid for a period equal to that of Improvement Permit – not to exceed sixty months.

Signed: James Stanley date 2-8-00

Improvement Permit by: Jo Potter date

Authorization to Construct by: Jo Potter date

Installed by: A1 Backhoe

Operation Permit by: Jo Potter date Feb 9 2000

Existing System Inspection by: date

HEALTH DEPT. COPY: WHITE OWNER COPY (FINAL): YELLOW OWNER COPY (INITIAL): PINK