IREDELL COUNTY HEALTH DEPARTMENT

STATESVILLE 704-878-5305 MOORESVILLE 704-664-5281

IMPROVEMENT PERMIT / CERTIFICATE OF COMPLETION / OPERATION PERMIT / EXISTING SYSTEM INSPECTION

6563

PROPERTY DESCRIPTION NO 25463 DATE 3-5-97

OWNER OR CONTRACTOR Mickey Hagger TAX MAP NO. 8V-A-2

ADDRESS P.O. Box 484 Stony Point NC 28678 PHONE: Business _____ Home 585-6471

LOCATION I-40 TROM Mtn Rd To County line Rd go approx 1 mile lot on left Watershed: ☐ Yes ☒ No WSIV PA

SUBDIVISION Victoria's Landing BLOCK / SECTION _____ LOT #7 LOT AREA _____ SITE CLASS. P/S DESIGN FLOW 360 L.T.A.R. 0.3

Septic Tank: 1000 Gallons; STB 1012 Date 1-97

Pump Tank: _____ Gallons; PT _____ Date _____

Pump Make: _____ Model _____ Serial No. _____

Nitrification Field: No Fields 1 Square Feet 1200 Linear Feet 400

No Lines 6 Trench Width 36in Max Trench Bottom Depth 36in Gravel Depth 12in

☒ New System ☐ Repair System Type: I (II) III, IV, V, VI

System Description: Gravity Conventional

Repair System Description: Pump & Chambers

Maintenance Agreement Required: ☐ Yes ☒ No

☐ Slab ☒ Crawl Space ☐ Basement w/plumbing ☐ Basement wo/plumbing

☐ House/Mod. Home ☒ Mobile Home ☐ Business ☐ Other


No. Bedrooms 3 No. Bathrooms 2 No. Employees ____

Water Supply: ☐ Individual ☐ Community ☐ Public


Comments: Keep lines on contour 9ft on center

Comments:

INITIAL SITE SKETCH

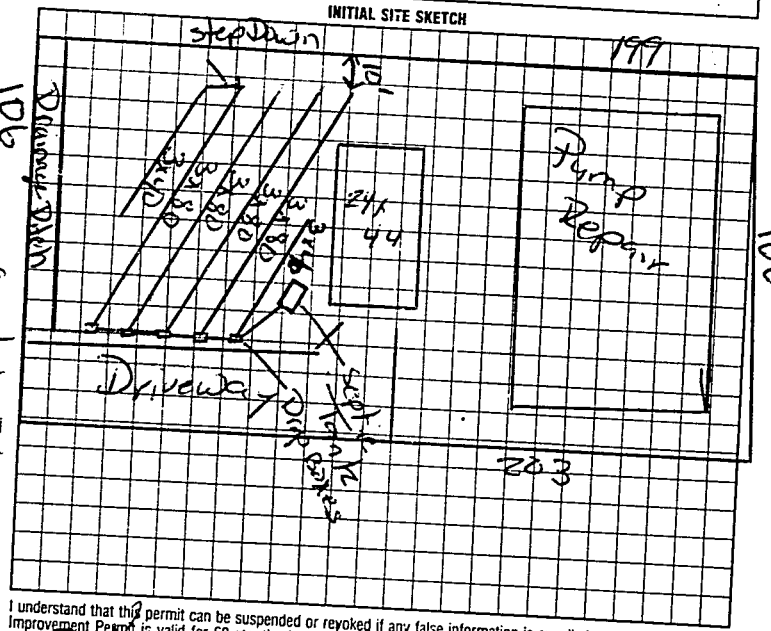

AS BUILT SKETCH

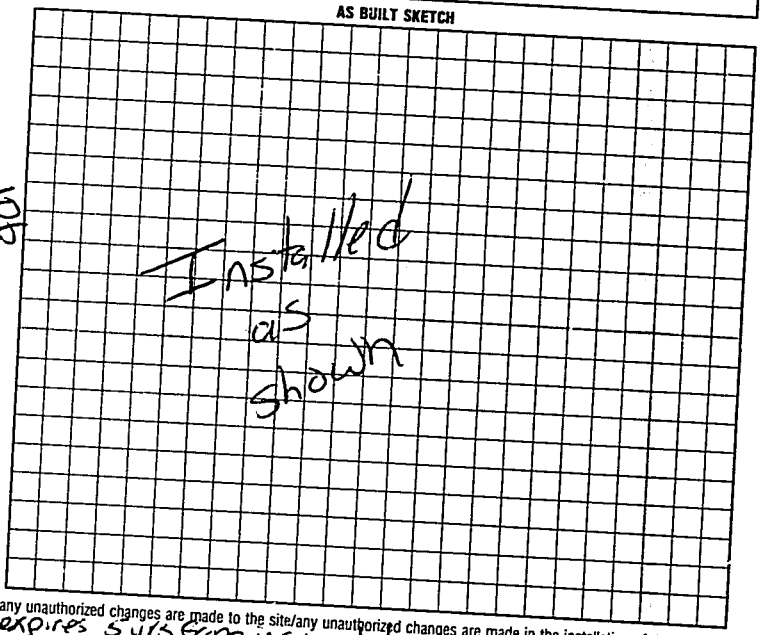

I understand that this permit can be suspended or revoked if any false information is supplied toward securing the permit/any unauthorized changes are made to the site/any unauthorized changes are made in the installation of the system. Improvement Permit is valid for 60 months from date of issuance. Authorization to construct expires 5 yrs from issue date

Signed: X Mickey Hagger

Improvement Permit by: Authorization const. Mark C Orf RS date 3-5-97

Existing System Inspection by: Mark C Orf RS date 3-5-97

Installed by: Tom Cothern

Certificate of Completion by: _____ date _____

Operation Permit by: Mark C Orf RS date 4-22-97

HEALTH DEPT COPY: WHITE INSPECTION COPY (FINAL): GREEN OWNER COPY (FINAL): YELLOW INSPECTION COPY (INITIAL): PINK OWNER COPY (INITIAL): GOLD