IREDELL COUNTY HEALTH DEPARTMENT

STATESVILLE 704-878-5305 ✓ MOORESVILLE 704-664-5281

IMPROVEMENT PERMIT / AUTHORIZATION TO CONSTRUCT / OPERATION PERMIT / EXISTING SYSTEM INSPECTION

PERMIT# 110454 PIN# 3785-79-6357 DATE 12/23/02

OWNER OR CONTRACTOR Fleetwood Homes PHONE: Business (704) 872-0179 Home —

ADDRESS 1270 Northside Drive Statesville N.C. 28625

LOCATION I-40 W, (R) Old Mth Rd., (L) County Line Rd., (L) Jordan Crest Lane, on right.

SUBDIVISION Victoria's Landmark BLOCK / SECTION 2 LOT 26 LOT AREA ±.47 Ac. SITE CLASS P5 DESIGN FLOW 360 L.T.A.R. ±.30 gpd/ft²

Septic Tank: 4000 Gallons; STB C-87012 Date 6-3-02

Pump Tank: — Gallons; PT — Date —

Pump Make: — Model — Serial No. —

Nitrification Field: No Fields 1 Square Feet 1200 Linear Feet 200

No Lines 4@50ft Trench Width 2ft Max Trench Bottom Depth 36" Gravel Depth NA

☒ New System ☐ Repair System Type: I, II, (III) IV, V, VI

System Description: Gravity, 50% reduction

Repair System Description: Pump, LPP

Maintenance Agreement Required: ☐ Yes ☒ No

☐ House/Mod. Home ☒ Mobile Home ☐ Business ☐ Other

No. Bedrooms 3 No. Bathrooms 2 No. Employees —


☐ Slab ☒ Crawl Space ☐ Basement w/plumbing ☐ Basement wo/plumbing

Water Supply: ☐ Individual ☒ Public ☐ Community

Comments:/Conditions: ① Install 46 Panels ON contour with (1) One Flow divider tee and (2) two dist. boxes ② Lime sidewalls, use Approximately 33 Tons of sand. –

Comments:/Conditions: – Tuff-Tite filter + S.T. marker Installed

INITIAL SITE SKETCH Scale 1"= 50'

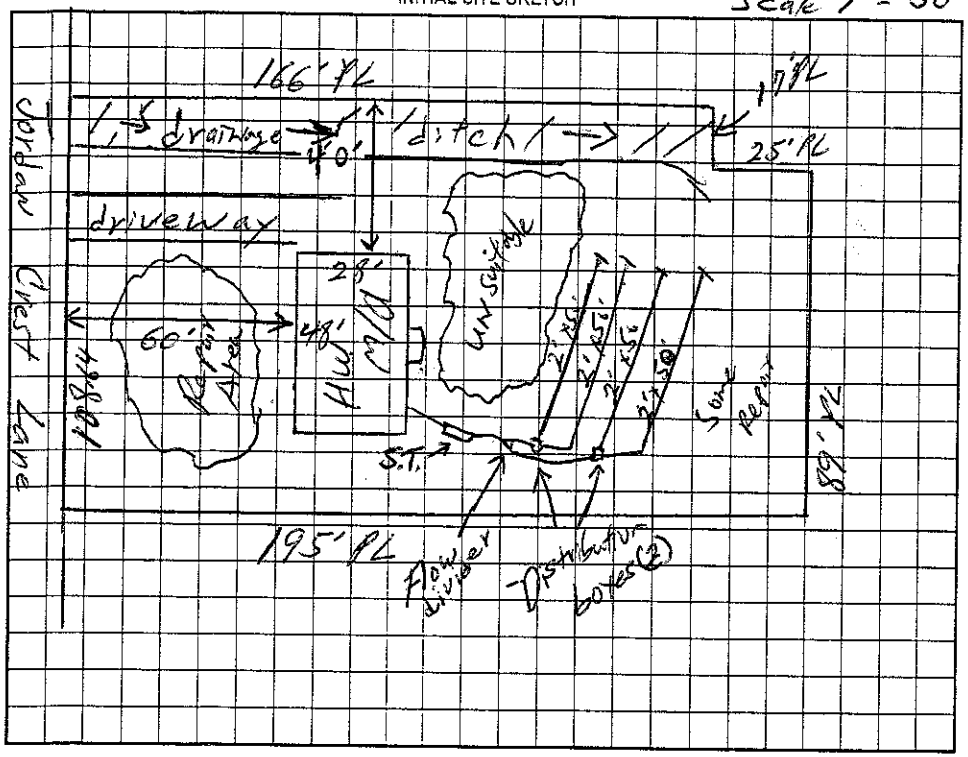

AS BUILT SKETCH

Installed as Shown per Initial Site Sketch

Permit can be suspended or revoked if any false information is supplied toward securing the permit/any unauthorized changes are made to the site/any unauthorized changes are made in the installation of the system. Improvement Permit with plat valid without expiration. Improvement Permit with site plan valid for sixty months. Authorization to Construct is valid for a period equal to that of Improvement Permit – not to exceed sixty months.

Signed: Renee M. Hall date 1-6-03 Installed by: Craig Thompson

Improvement Permit by: William O. Johnson date 12/30/02 Operation Permit by: William O. Johnson date 1/14/03

Authorization to Construct by: William O. Johnson date 12/30/02 Existing System Inspection by: — date —

HEALTH DEPT. COPY: WHITE OWNER COPY (FINAL): YELLOW OWNER COPY (INITIAL): PINK