IREDELL COUNTY HEALTH DEPARTMENT

STATESVILLE 704-878-5305 MOORESVILLE 704-664-5281

IMPROVEMENT PERMIT / AUTHORIZATION TO CONSTRUCT / OPERATION PERMIT / EXISTING SYSTEM INSPECTION

PERMIT# 83428 PIN# ~~38~~ 3785-79 6611 DATE Sept 22, 99

OWNER OR CONTRACTOR Randi Roberts PHONE: Business 873 4335 Home

ADDRESS 155 Ross Catfish DR Statesville, NC

LOCATION N Old Mt Rd ⓛ County Line Rd ⓡ Jordan Crest on Left

SUBDIVISION Victorias Landmark BLOCK / SECTION LOT 14 LOT AREA .63 Ac SITE CLASS PS DESIGN FLOW 360 L.T.A.R. .33

Septic Tank: 1000 Gallons; STB 1007 Date 12499
Pump Tank: Gallons; PT Date
Pump Make: Model Serial No.
Nitrification Field: No Fields 1 Square Feet 1090 Linear Feet 270
No Lines 4 Trench Width 36" Max Trench Bottom Depth 36" Gravel Depth N/A

☒ New System ☐ Repair System Type: I, II, ⓘ IV, V, VI
System Description: 25% Reduction GRAVITY
Repair System Description: Same
Maintenance Agreement Required: ☐ Yes ☒ No

☐ House/Mod. Home No. Bedrooms 3
☒ Mobile Home SW No. Bathrooms 2
☐ Business No. Employees
☐ Other


☐ Slab ☒ Crawl Space ☐ Basement w/plumbing ☐ Basement wo/plumbing

Water Supply: ☐ Individual ☒ Public ☐ Community


Comments/Conditions: Install on Contour

Comments/Conditions:

INITIAL SITE SKETCH

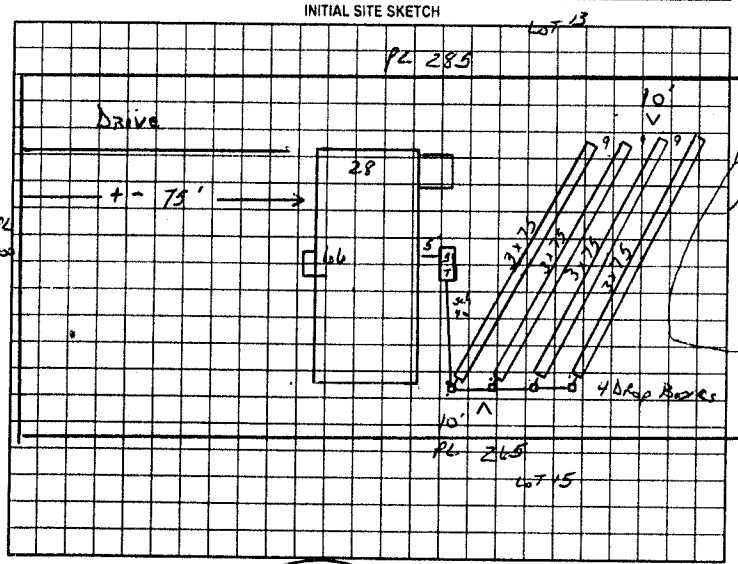

AS BUILT SKETCH

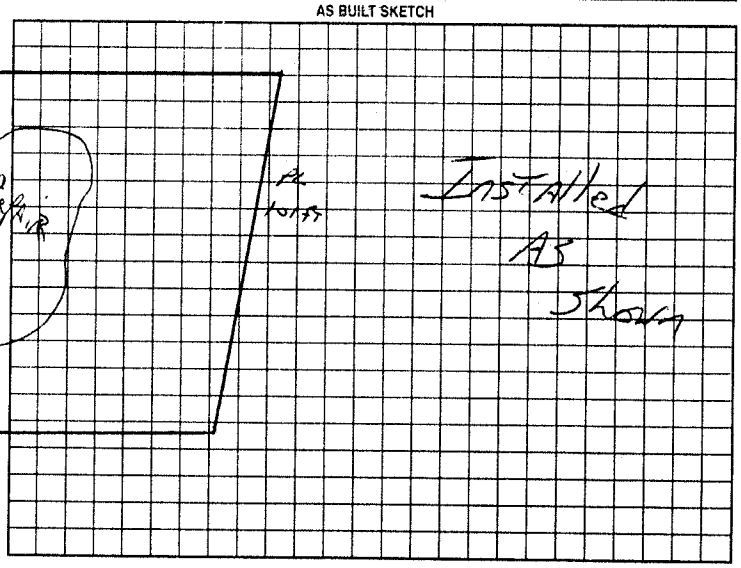

Permit can be suspended or revoked if any false information is supplied toward securing the permit/any unauthorized changes are made to the site/any unauthorized changes are made in the installation of the system. Improvement Permit with plat valid without expiration. Improvement Permit with site plan valid for sixty months. Authorization to Construct is valid for a period equal to that of Improvement Permit – not to exceed sixty months.

Signed: Jim Roeller date 9/24/99 Installed by: James Huddleston

Improvement Permit by: JC Potter date Sept 22 99 Operation Permit by: JC Potter date Jan 13. 2000

Authorization to Construct by: JC Potter date Sept 22 99 Existing System Inspection by: date

HEALTH DEPT COPY: WHITE OWNER COPY (FINAL) YELLOW OWNER COPY (INITIAL) PINK