IREDELL COUNTY HEALTH DEPARTMENT

STATESVILLE 704-878-5305 (C1) MOORESVILLE 704-664-5281

IMPROVEMENT PERMIT / AUTHORIZATION TO CONSTRUCT / OPERATION PERMIT / EXISTING SYSTEM INSPECTION

PERMIT# 123820 PIN# 3785-80-6689 DATE 9-9-04

OWNER OR CONTRACTOR SHANE MAYBERRY PHONE: Business 704-902-6352 Home

ADDRESS 252 BOLICK ROAD, SPENCER POINT, NC 28678

LOCATION I-40 WEST, TR OLD MOUNTAIN RD, TL NEW STERLING RD, TR LINDEN LOOP, TR BOLICK ROAD, 0.5 mi. on RIGHT

SUBDIVISION BLOCK / SECTION LOT LOT AREA 0.96 ACRE SITE CLASS. P5 DESIGN FLOW 360 L.T.A.R. 0.30 GPD/FT²

Septic Tank: ~~HOLDING~~ Gallons; STB 1012 Date 6-8-96
Pump Tank: Gallons; PT Date
Pump Make: Model Serial No.
Nitrification Field: No Fields 1 Square Feet 270 Linear Feet 90
No Lines ONE Trench Width 36" Max Trench Bottom Depth 36" Gravel Depth 12"

☑ New System ☐ Repair System Type: I, II, III, IV, V, VI
System Description: CONVENTIONAL, GRAVITY
Repair System Description: CONVENTIONAL, PUMP
Maintenance Agreement Required: ☐ Yes ☑ No


☐ House/Mod. Home No. Bedrooms 3
☑ Mobile Home No. Bathrooms 2
☐ Business No. Employees
☐ Other
☐ Slab ☐ Crawl Space ☐ Basement w/plumbing ☐ Basement wo/plumbing

Water Supply: ☑ Individual ☐ Public ☐ Community WELL

Comments:/Conditions: ① RELOCATE SEPTIC TANK AS SHOWN. ② EXCAVATE UPPER THREE LINES AT LOCATION SHOWN & FILL WITH PACKED ③ CLAY SOIL TO CREATE DAM ③ INSTALL NEW 3'x90' DRAINLINE ON CONTOUR AT LOCATION SHOWN

Comments:/Conditions: ④ NECESSARY EASEMENTS SHALL BE OBTAINED PRIOR TO ISSUANCE OF AUTHORIZATION TO CONSTRUCT. ⑤ (SEE ATTACHED EASEMENT)

INITIAL SITE SKETCH

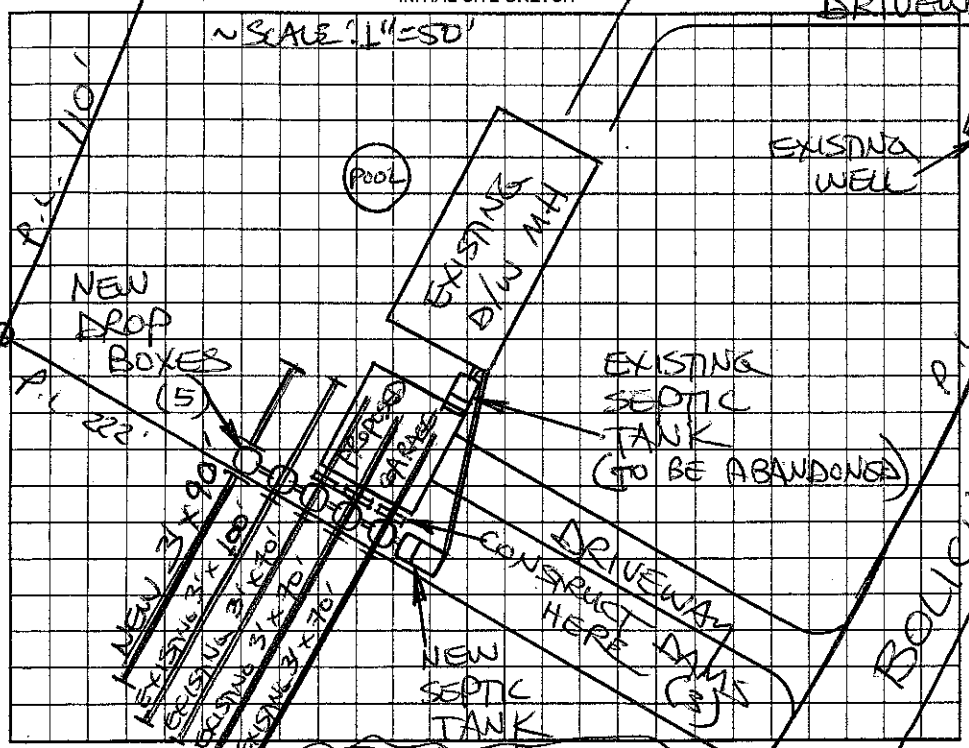

AS BUILT SKETCH

SYSTEM RELOCATED ACCORDING TO 'INITAL SITE SKETCH

Permit can be suspended or revoked if any false information is supplied on any securing the permit/any unauthorized changes are made to the site/any unauthorized changes are made in the installation of the system. Improvement Permit with plat valid without expiration. Improvement Permit with site plan valid for sixty months. Authorization to Construct is valid for a period equal to that of Improvement Permit – not to exceed sixty months.

Signed: Shane Mayberry date

Improvement Permit by: STEVE HEDRICK date 9-9-04

Authorization to Construct by: STEVE HEDRICK date 10-1-04

Installed by: CRAIG THOMPSON

Operation Permit by: STEVE HEDRICK date 10-8-04

Existing System Inspection by: date

HEALTH DEPT. COPY: WHITE OWNER COPY (FINAL): YELLOW OWNER COPY (INITIAL): PINK