IREDELL COUNTY HEALTH DEPARTMENT

Authorization to construct

STATESVILLE 704-878-5305 MOORESVILLE 704-664-5281

IMPROVEMENT PERMIT / CERTIFICATE OF COMPLETION / OPERATION PERMIT / EXISTING SYSTEM INSPECTION

PROPERTY DESCRIPTION NO. 25482 DATE 11-14-96 TAX MAP NO. 8VA-84 Watershed: ☐ Yes ☒ No

OWNER OR CONTRACTOR Shane Mayberry PHONE: Business _____ Home 872-8121

ADDRESS 129 W Treadell Circle Statesville

LOCATION I-40 TL Old Mtn TL New Sterling TR Linden TR Bolick 1/2 mile on R.

SUBDIVISION _____ BLOCK / SECTION _____ LOT 8 LOT AREA _____ SITE CLASS P/S DESIGN FLOW 360 L.T.A.R. 0.3

Septic Tank: 1000 Gallons; STB 1013 Date 12-8-96

Pump Tank: _____ Gallons; PT _____ Date _____

Pump Make: _____ Model _____ Serial No. _____

Nitrification Field, No Fields 1 Square Feet 1200 Linear Feet 400

No Lines 4 Trench Width 36in Max Trench Bottom Depth 32in Gravel Depth 12in

☒ New System ☐ Repair System Type: I II III IV V VI

System Description: Gravel Conventional

Repair System Description: Pump Capsule/Gravel

Maintenance Agreement Required: ☐ Yes ☒ No Contract

☐ House/Mod. Home ☒ Mobile Home ☐ Business ☐ Other

No. Bedrooms 3 No. Bathrooms 2 No. Employees ___

☐ Slab ☒ Crawl Space ☐ Basement w/plumbing ☐ Basement wo/plumbing

Water Supply: ☒ Individual ☐ Community ☐ Public


Comments:

keep lines on contour 9ft on center


keep well 100ft from system

Comments:

INITIAL SITE SKETCH

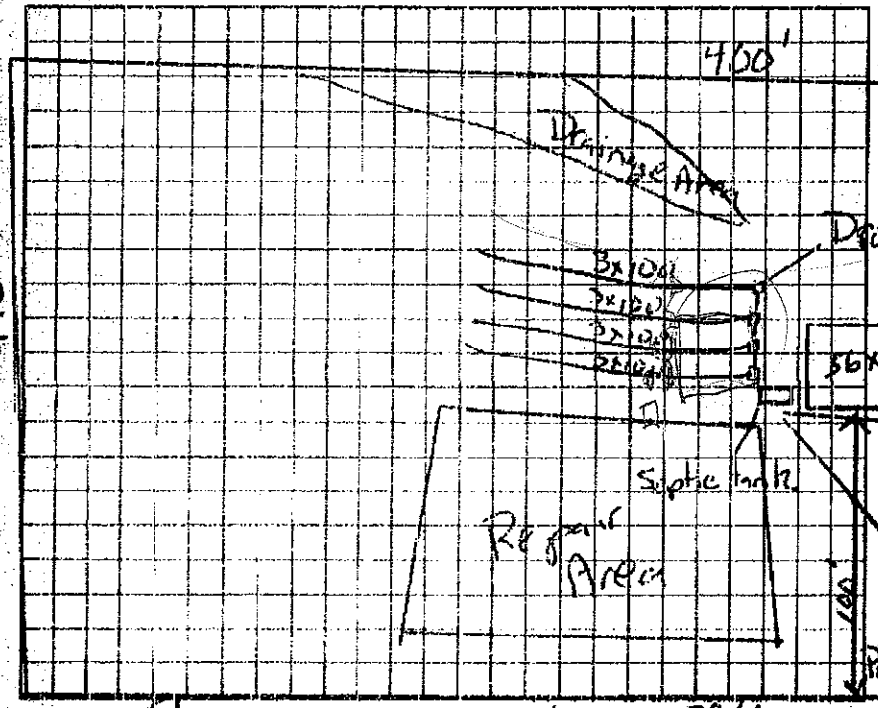

AS BUILT SKETCH

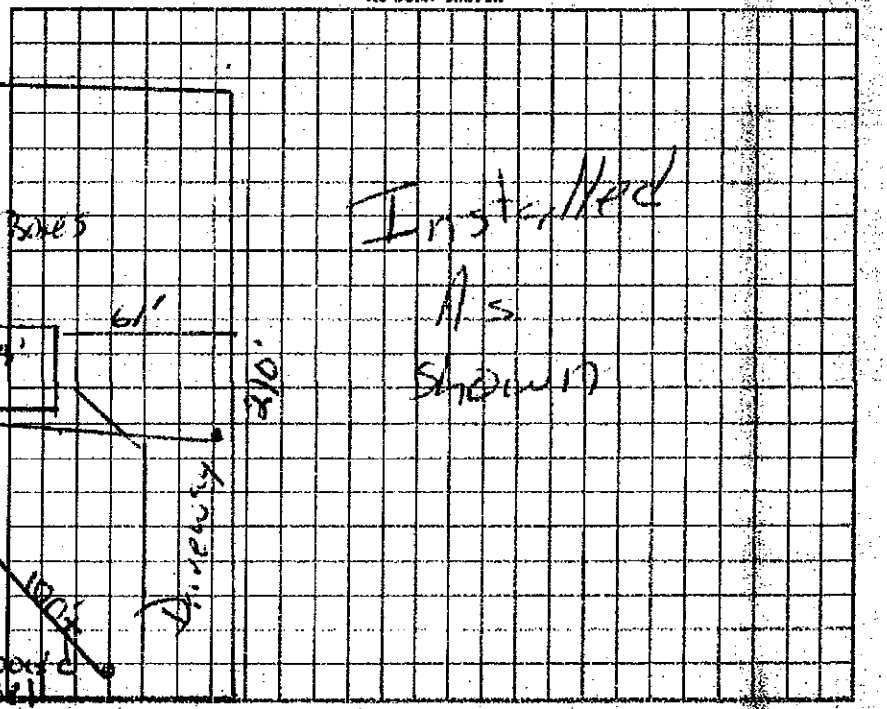

I understand that this permit can be suspended or revoked if any false information is supplied toward securing the permit, any unauthorized changes are made to the site, any unauthorized changes are made in the installation of the system.

Signed: X [signature] Bolick Rd

Improvement Permit by: [signature] date 11-14-96

Authorization to construct expires 5 yr from issue date

Installed by: A-1 Backhoe

Certificate of Completion by: _____ date _____

Operation Permit by [signature] date 11-27-96

HEALTH DEPT COPY: WHITE INSPECTION COPY (INITIAL): GREEN OWNER COPY (FINAL): YELLOW INSPECTION COPY (INITIAL): PINK OWNER COPY (INITIAL): GOLD

JAN. 2, 1989 23:34