IREDELL COUNTY HEALTH DEPARTMENT

STATESVILLE 704-878-5305 MOORESVILLE 704-664-5281

IMPROVEMENT PERMIT / AUTHORIZATION TO CONSTRUCT / OPERATION PERMIT / EXISTING SYSTEM INSPECTION

PERMIT# 87726 PIN# 3785900973 DATE Feb 28 2000

OWNER OR CONTRACTOR Candace Mayberry PHONE: Business Home 873 4755

ADDRESS 129 W. Iredell Cir. Statesville

LOCATION Old Mtn Rd N (L) New Sterling (R) Linden (R) Bolick ~¼ on Right

SUBDIVISION BLOCK / SECTION LOT LOT AREA 1.3± SITE CLASS PS DESIGN FLOW 360 L.T.A.R. .25 Repair .3

Septic Tank: 1000 Gallons; STB 1012 Date 11-16-99
Pump Tank: Gallons; PT Date
Pump Make: Model Serial No.
Nitrification Field: No Fields 1 Square Feet 1840 Linear Feet 480
No Lines 5 Trench Width 36" Max Trench Bottom Depth 30" Gravel Depth 12"

☑ New System ☐ Repair System Type: I (II) III, IV, V, VI
System Description: GRAVITY Conventional
Repair System Description: Reduction W/Pump
Maintenance Agreement Required: ☐ Yes ☒ No


☐ House/Mod. Home No. Bedrooms 3
☒ Mobile Home SW No. Bathrooms 2
☐ Business No. Employees
☐ Other
☐ Slab ☒ Crawl Space ☐ Basement w/plumbing ☐ Basement wo/plumbing

Water Supply: ☒ Individual ☐ Public ☐ Community
WELL


Comments/Conditions: Shallow Trench
Bolick Rd

Comments/Conditions.

INITIAL SITE SKETCH

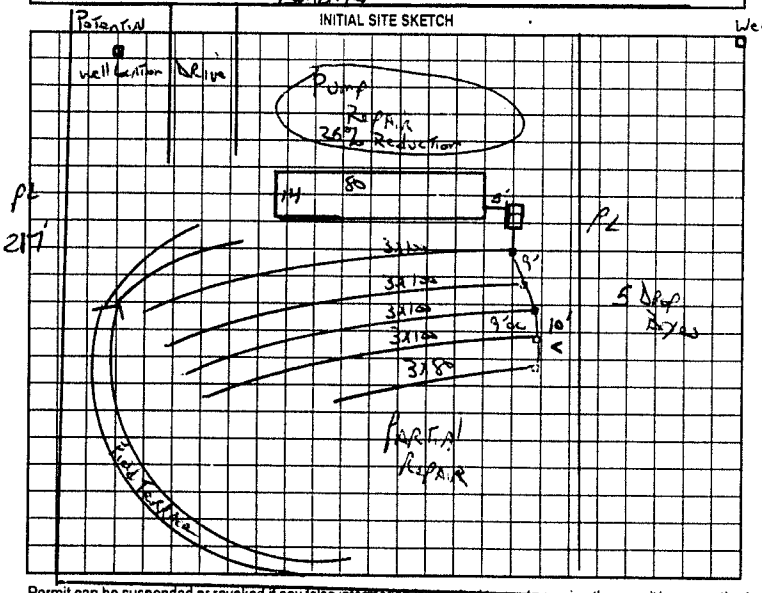

AS BUILT SKETCH

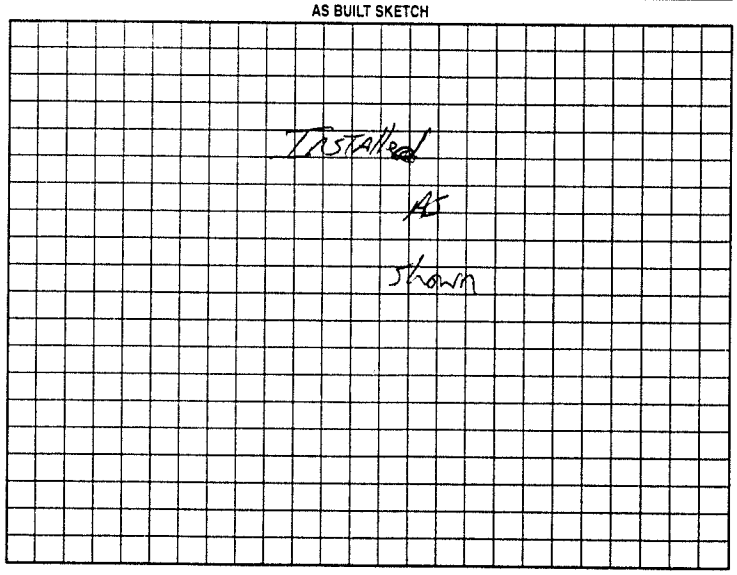

Permit can be suspended or revoked if any false information is supplied toward securing the permit/any unauthorized changes are made to the site/any unauthorized changes are made in the installation of the system. Improvement Permit with plat valid without expiration. Improvement Permit with site plan valid for sixty months. Authorization to Construct is valid for a period equal to that of Improvement Permit – not to exceed sixty months.

Signed: Candace Mayberry date Feb 28 2000 Installed by: E. Elder

Improvement Permit by: C Potter date Feb 28 2000 Operation Permit by: C Potter date March 9 2000

Authorization to Construct by: C Potter date Feb 28 2000 Existing System Inspection by: date

HEALTH DEPT. COPY: WHITE OWNER COPY (FINAL): YELLOW OWNER COPY (INITIAL): PINK