ICHD - ENVIRONMENTAL HEALTH DIVISION

Statesville Office (704) 878-5305 Mooresville Office (704) 660-3625

MW

MANF-2023-28536

PERMIT # 2023-19298

SEPTIC: IMPROVEMENT PERMIT / AUTHORIZATION TO CONSTRUCT / OPERATION PERMIT / EXISTING SYSTEM

PIN # 3785 -- 89 -- 0328

APPLICANT/OWNER: Jerry Hager APPLICANT ADDRESS:


SITE DIRECTIONS: Old Mtn - County Line - Jordan Crest SAP CONTROLLED: ☐ YES ☒ NO


SUBDIVISION: Victorias Landmark SECTION: 2 LOT # 23 LOT AREA: 0.47 acres DESIGN FLOW: 360 gpd L.T.A.R.: 0.3

Septic Tank	1000 (gal)	STB	160	Date	6/19/23	☒ New System ☐ Repair ☐ Expansion	System Type: I II (III) IV V VI	☒ Residence	No. Bedrooms 3
Pump Tank	(gal)	PT		Date		System Description:	25% reduction	☐ Business	No. Persons 6
Pump Make		Model		Serial #		Repair System Description:	LP - PPBPS	☐ Other	No. Employees
# Nitrification Fields	1	# Lines	4	Linear Ft	300'	Maintenance Agreement Required:	☐ YES ☒ NO	☐ Slab	☒ Crawl Space
Trench Width	36 in	Trench Bottom Depth ~~(Low side)~~	36" max	Gravel Depth	-		☒ GRAVITY ☐ PRESSURE	☐ Basement w/plumbing	☐ Basement w/o plumbing

Water Supply: ☐ Private ☒ Public ☐ Community

Comments / Conditions: Install lines on contour with the land. Do not grade, park, or drive on septic area.

INITIAL SITE SKETCH

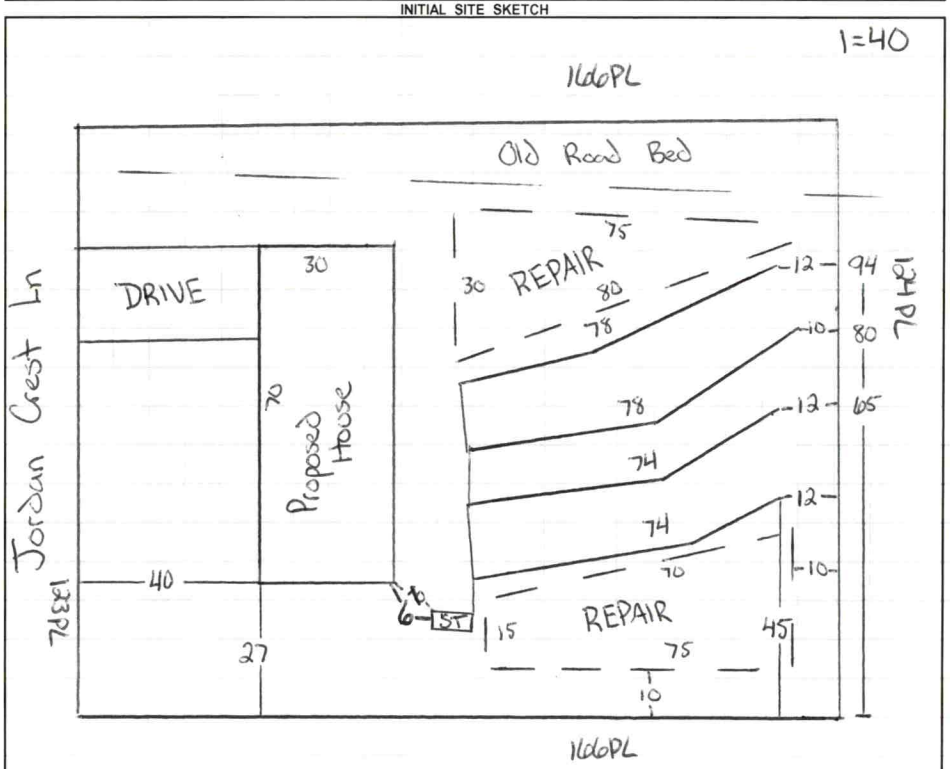

AS BUILT SKETCH

FOR SEPTIC FINAL INSPECTION CALL: 704-664-3703 between 8am-9am the day the inspection is needed. Be sure to speak with an inspector to confirm your time.

Installed as Drawn

Permit can be suspended or revoked if any false information is supplied toward securing the permit / any unauthorized changes are made to the site / any unauthorized changes are made in the installation of the system. **CONTACT A LOCATOR SERVICE PRIOR TO ANY EXCAVATION**

☐ **IMPROVEMENT PERMIT** ***with plat*** *valid without expiration.* ☒ **IMPROVEMENT PERMIT** ***with site plan*** *valid for 60 mos.* ☒ **AUTHORIZATION TO CONSTRUCT** *valid for period equal to IMPROVEMENT PERMIT--not to exceed 60 mo.*

Owner / Applicant Signature: Online Signature Date:

IMPROVEMENT PERMIT by: Cary Wil Date: 5/4/23

AUTHORIZATION TO CONSTRUCT by: Cary Wil Date: 5/24/23

Installed by: K & M Septic

OPERATION PERMIT by: Cary Wil Date: 9/19/23

Existing System Inspected by: Date:

FOR SEPTIC FINAL INSPECTION: CALL 704-664-3703 between 8am-9am the day the inspection is needed.

Item	Date	Initials
Drain Lines Checked		
Tanks Checked		
Pressure Manifold or Valve Box Checked		
Pressure Head Set		
Electrical Checked		
Floats Set		
Alarm Checked		
Maintenance Contract Needed? Y / N		
Comments:		

Repairs Only	
	State Code
Failing System Code	
Type of Distribution	G or P
Type of Failure/Malfunction	
Primary Cause of Failure/Malfunction	
Age of System? _____	
Initial or Repair? _____	

DEPARTMENT OF HEALTH AND HUMAN SERVICES
DIVISION OF PUBLIC HEALTH, ENVIRONMENTAL HEALTH SECTION
ON-SITE WATER PROTECTION BRANCH

Sheet 1 of 1
PROPERTY ID #: 3785890328
COUNTY: Iredell

160 Jordan Crest

SOIL/SITE EVALUATION
***for* ON-SITE WASTEWATER SYSTEM**
(Complete all fields in full)

OWNER: Jerry Hager
ADDRESS:
APPLICATION DATE 3/17/23
DATE EVALUATED: 5/3/23
PROPOSED FACILITY: 3 bd/c home
PROPOSED DESIGN FLOW (.1949): 360 gpd
PROPERTY SIZE: 0.47 acres
LOCATION OF SITE: 160 Jordan Crest
PROPERTY RECORDED: yes
WATER SUPPLY: Private Public Well Spring Other
EVALUATION METHOD: Auger Boring X Pit Cut
TYPE OF WASTEWATER: Sewage Industrial Process Mixed

PROFILE #	.1940 LANDSCAPE POSITION/ SLOPE %	HORIZON DEPTH (IN.)	SOIL MORPHOLOGY (.1941) .1941 STRUCTURE/ TEXTURE	SOIL MORPHOLOGY (.1941) .1941 CONSISTENCE/ MINERALOGY	OTHER PROFILE FACTORS .1942 SOIL WETNESS/ COLOR	.1943 SOIL DEPTH	.1956 SAPRO CLASS	.1944 RESTR HORIZ	PROFILE CLASS & LTAR
1	Linear 10%.	0 - 26	C SBK	SS SP FR SE	-	49	-	-	.35 PS
		26 - 49	CL SBK	SS SP FR SE					
2	Linear 12%.	0-24	C SBK	SS SP FR FM	NA	48	-	-	PS .30+ Mica Mushwt
		24-48	CL WSBK	SS SP FR FM					
3	Linear 10%.	0 - 24	C SBK	SS SP FR SE	-	48	-	-	.3 PS
		24 - 48	CL SBK	SS SP FR SE					
4	Linear 8%.	0 - 22	C SBK	SS SP FR SE	-	48	-	-	.3 PS
		22 - 48	CL SBK	SS SP FR SE					

DESCRIPTION	INITIAL SYSTEM	REPAIR SYSTEM
Available Space (.1945)	PS	PS
System Type(s)	25%	50%
Site LTAR	.3	.3

OTHER FACTORS (.1946):
SITE CLASSIFICATION (.1948): PS
EVALUATED BY: Cody Whicker
OTHER(S) PRESENT: Ben Bathins

COMMENTS:

Updated February 2014

LEGEND

use the following standard abbreviations

LANDSCAPE POSITION	GROUP	SOIL TEXTURE	CONVENTIONAL .1955 LTAR*	LPP .1957 LTAR*	MINERALOGY/ CONSISTENCE	STRUCTURE
CC (Concave Slope)	I	S (Sand)	1.2 - 0.8	0.6 - 0.4	SEXP (Slightly Expansive)	G (Single Grain)
CV (Convex Slope)		LS (Loamy Sand)			EXP (Expansive)	M (Massive)
D (Drainage Way)						CR (Crumb)
DS (Debris Slump)	II	SL (Sandy Loam)	0.8 - 0.6	0.4 - 0.3		GR (Granular)
FP (Flood Plain)		L (Loam)				SBK (Subangular Blocky)
FS (Foot Slope)						ABK (Angular Blocky)
H (Head Slope)	III	Si (Silt)	0.6 - 0.3	0.3 - 0.15		PL (Platy)
L (Linear Slope)		SiCL (Silty Clay Loam)				PR (Prismatic)
N (Nose Slope)		CL (Clay Loam)				
R (Ridge)		SCL (Sandy Clay Loam)			**MOIST**	**WET**
S (Shoulder Slope)		SiL (Silt Loam)				
T (Terrace)					VFR (Very Friable)	NS (Non-sticky)
	IV	SC (Sandy Clay)	0.4 - 0.1	0.2 - 0.05	FR (Friable)	SS (Slightly Sticky)
		SiC (Silty Clay)			FI (Firm)	S (Sticky)
		C (Clay)			VFI (Very Firm v. Very Sticky)	VS (Very Sticky)
		O (Organic)	None	None	EFI (Extremely Firm)	NP (Non-plastic)
						SP (Slightly Plastic)
						P (Plastic)
						VP (Very Plastic)

*Adjust LTAR due to depth, consistence, structure, soil wetness, landscape, position, wastewater flow and quality.


NOTES

HORIZON DEPTH	In inches below natural soil surface
DEPTH OF FILL	In inches from land surface
RESTRICTIVE HORIZON	Thickness and depth from land surface
SAPROLITE	S(suitable) or U(unsuitable)
SOIL WETNESS	Inches from land surface to free water or inches from land surface to soil colors with chroma 2 or less - record Munsell color chip designation
CLASSIFICATION	S (Suitable), PS (Provisionally Suitable), or U (Unsuitable)

Evaluation of saprolite shall be by pits.

Long-term Acceptance Rate (LTAR): gal/day/ft^2

Show profile locations and other site features (dimensions, reference or benchmark, and North).

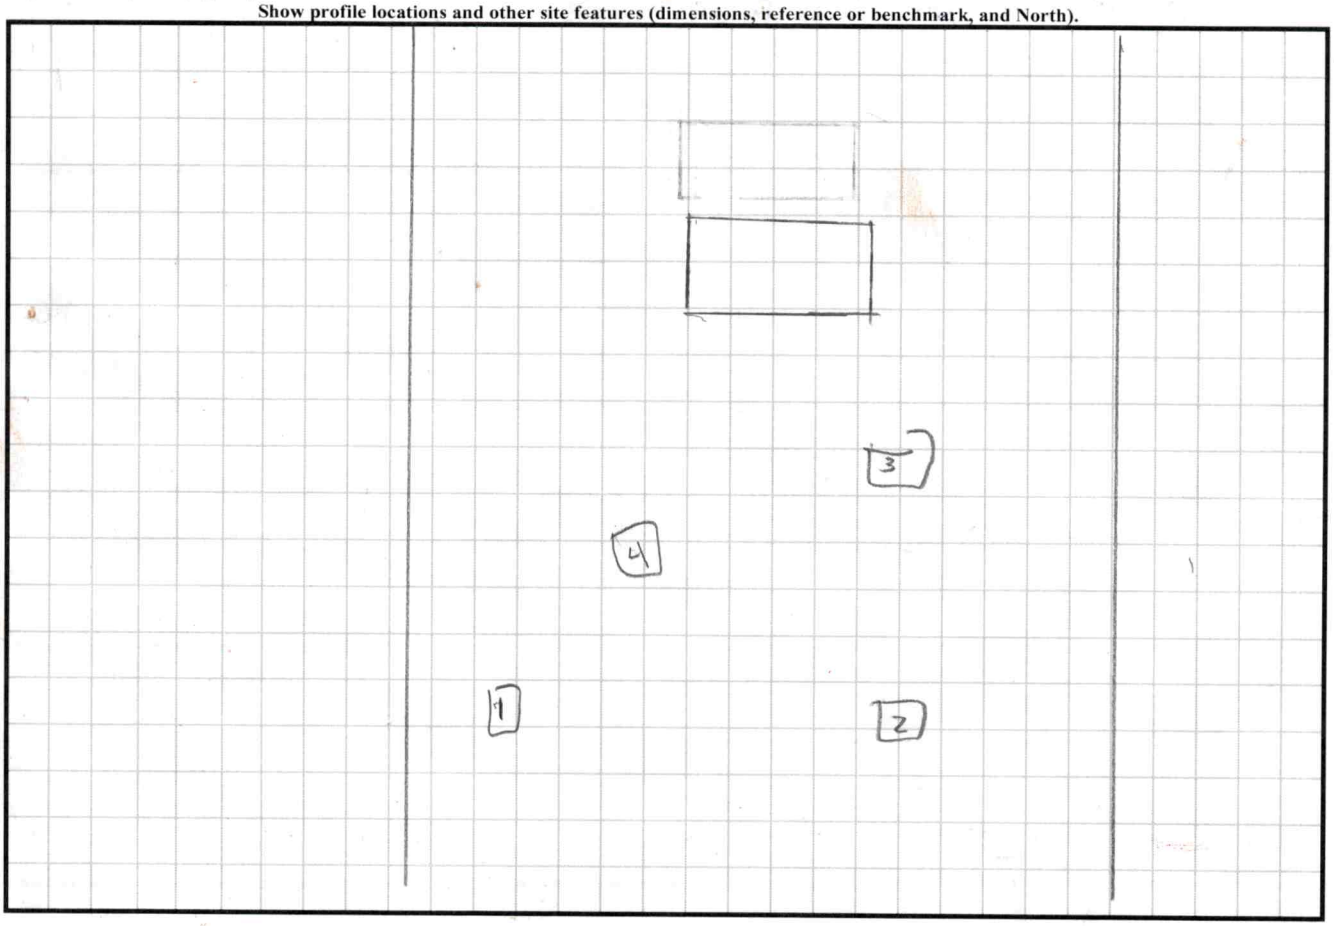

PERMIT SNAPSHOT REPORT OSWP-2023-19298 FOR IREDELL COUNTY

Permit Type: Environmental Health OSWP
Work Class: EH Septic Permit
Status: In Progress
Valuation: $0.00
Description: See internal notes APPLYING FOR IP AC PERMIT

Project:
District: Iredell County
Square Feet: 0.00
Assigned To: Whicker, Cory

App Date: 03/17/2023
Exp Date: NOT AVAILABLE
Completed: NOT COMPLETED
Approval Expire Date:

Parcel: 3785890328.000 Main
Address: 160 Jordan Crest Ln Stony Point, NC 28678 Main
Zone: RA(Residential Agricultural District)

Property Owner
JERRY L HAGER
Mobile: (828) 461-8966

Applicant/Authorized Agent
JERRY L HAGER
Mobile: (828) 461-8966

Permit Custom Fields

How is your site plan being submitted	Custom Site Plan	Does the site contain any jurisdictional wetlands	No	Non-domestic Sewage Generated	No
Other Public Agency	No	All proposed structure dimensions	26 x 56	Maximum Number of Bedrooms	3
Number of Occupants	6	Foundation Type	Crawl Space Foundation	Residential/Business/Other	Residential
Desired Septic System Type	Conventional (most common)	Has this project been approved by TRC	No	Lot Acreage	0.47
Front Setback	35	Back Setback	35	Left Setback	15
Right Setback	15	Is the structure or development in the floodplain	No	Is the property in a local historic district?	No
Is the property located downtown?	No	Additional Unique Setbacks Apply	No		

Attachment File Name	Added On	Added By	Attachment Group	Notes
160 Jordan Crest Lane AA form_v1.pdf	03/17/2023 13:30	Williams, Deborah	Available Online	Authorize to Act as Agent
160 Jordan Crest Lane Site Plan_v1.pdf	03/17/2023 13:30	Williams, Deborah	Available Online	Site Plan
160 Jordan Crest Lane Floor Plan.jpg	03/17/2023 15:23	Nebel, Barbara	Available Online	FLOOR PLANS

Inspection Number	Status	Inspection Type	Request Date	Scheduled Start Date	Scheduled End Date	Actual Start Date	Actual End Date
2023-82657	Passed - Permit	OSWP Septic/Well Preliminary Site Visit	04/18/2023			04/18/2023 9:50	04/18/2023 9:50

Inspectors: Bracken, Sarah (Primary)


Checklist Item	Description	Passed	Comments
General Comments	Checklist item used to track general comments, not specific to any other checklist item	No	

Note	Created By	Date and Time Created


Invoice No.	Fee	Fee Amount	Amount Paid
INV-00010784	New Gravity System	$500.00	$500.00
	Iredell Zoning Tech Fee	$2.25	$2.25
	Iredell Zoning Permit Fee	$75.00	$75.00
	Total for Invoice INV-00010784	$577.25	$577.25
	Grand Total for Permit	**$577.25**	**$577.25**

PERMIT SNAPSHOT REPORT (OSWP-2023-19298)

Workflow Step / Action Name	Action Type	Start Date	End Date
Application Completeness Check v.1		03/17/2023 13:31	03/17/2023 13:31
Confirm application complete v.1	Generic Action		03/17/2023 13:31
Fees v.1		03/22/2023 9:10	03/22/2023 9:10
Issue Invoice v.1	Generic Action		03/22/2023 9:10
Fees Paid v.1	Generic Action		03/22/2023 9:10
Zoning Review v.1		03/17/2023 13:31	03/22/2023 9:12
~~Floodplain Admin Overview v.1~~	Task		03/17/2023 13:31
Iredell County Zoning Approval v.1	Task	03/17/2023 13:31	03/22/2023 9:12
Issue Invoice v.1	Generic Action		03/17/2023 13:31
Fees Paid v.1	Generic Action		03/22/2023 9:12
Lot Readiness Verification v.1		04/18/2023 9:50	
OSWP Septic Preliminary Site Visit v.1	Inspection	04/18/2023 9:50	04/18/2023 9:50
OSWP Site Evaluation v.1	Inspection		
Issue Improvement Permit v.1			
Issue Invoice v.1	Generic Action		
Fees Paid v.1	Generic Action		
Issue Permit v.1	Generic Action		
Permit Completion Process v.1			
Authorization to Construct Permit v.1	Create Sub Permit		
Issue Authorization to Construct v.1	Generic Action		

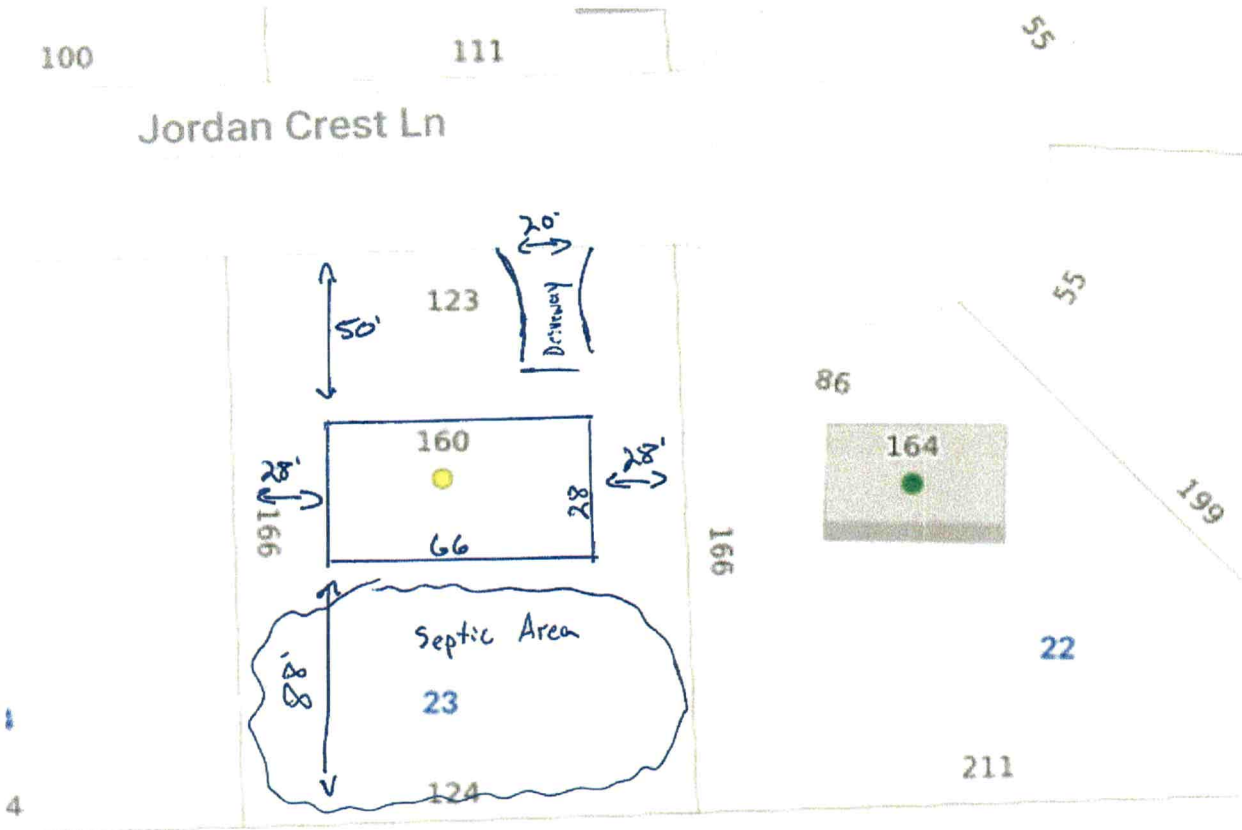
100
111
55
Jordan Crest Ln
20'
123
Driveway
50'
55
86
160
164
28'
28'
166
28
66
199
199
Septic Area
88'
22
23
211
124
4

3 bd 2 ba

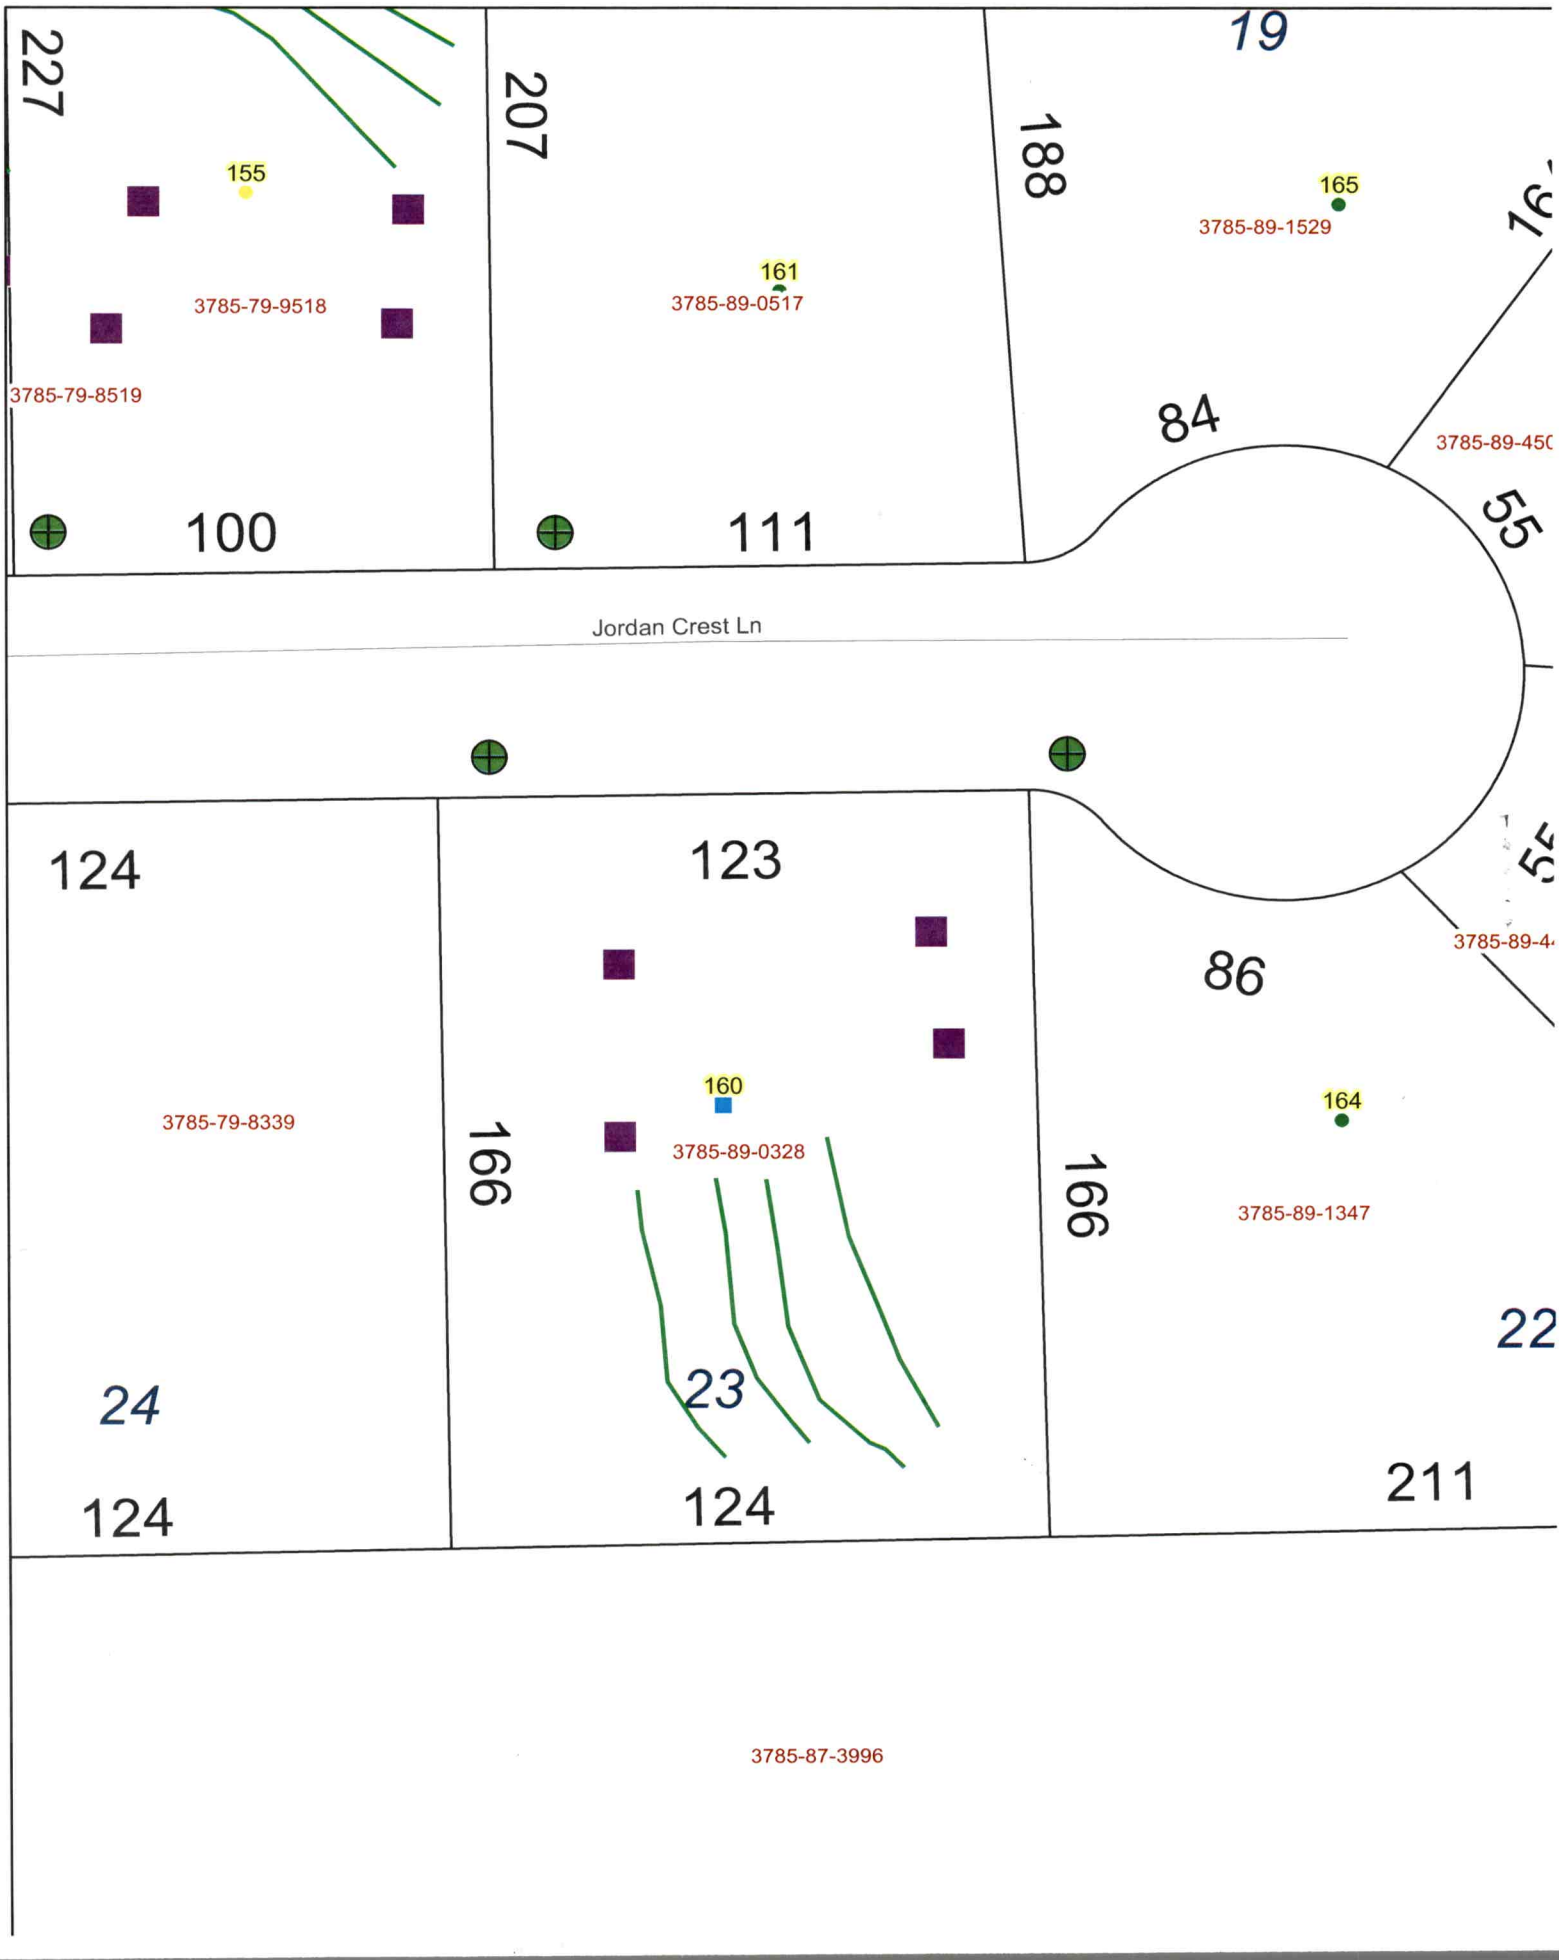
227
155
3785-79-9518
3785-79-8519
100
207
161
3785-89-0517
111
19
188
165
3785-89-1529
84
3785-89-450
55
Jordan Crest Ln
124
123
3785-79-8339
160
3785-89-0328
166
86
164
3785-89-1347
166
22
24
23
124
124
211
3785-87-3996