paid 125.00 12-17-98

IREDELL COUNTY HEALTH DEPARTMENT

STATESVILLE 704-878-5305 MOORESVILLE 704-664-5281

IMPROVEMENT PERMIT / AUTHORIZATION TO CONSTRUCT / OPERATION PERMIT / EXISTING SYSTEM INSPECTION

PERMIT# 077896 PIN# 3785 89 0517 DATE 12-16-98

OWNER OR CONTRACTOR RANDY ERVIN PHONE: Business Home 585-6396

ADDRESS 5045 TAYLORSVILLE HWY, STONY POINT, NC 28678

LOCATION I-40 W, TR OLD MTN. ROAD, TL COUNTY LINE ROAD, TL JORDAN CREST LANE, LOT AT END ON LEFT

SUBDIVISION VICTORIA'S LANDMARK SECTION II LOT 18 LOT AREA 20,720 SF SITE CLASS PS DESIGN FLOW 360 L.T.A.R. 0.2 GAD/PT

Septic Tank: 1000 Gallons: STB 160 Date 11-24-98
Pump Tank: Gallons: PT Date
Pump Make: Model Serial No.
Nitrification Field: No Fields 1 Square Feet EQ TO 1800 Linear Feet 300
No Lines EIGHT Trench Width 24" Max Trench Bottom Depth 36" Depth SAND 6"

✓ New System Repair System Type I II III IV V
System Description PPBPS GRAVITY
Repair System Description PPBPS GRAVITY
Maintenance Agreement Required Yes No


House/Mod. Home No. Bedrooms 3
Mobile Home No. Bathrooms 2
Business No. Employees
Other
Slab Crawl Space Basement w/plumbing Basement wo/plumbing

Water Supply: ☐ Individual ✓ Public ☐ Community

Comments/Conditions: ① INSTALL SIXTY-EIGHT (68) PPBPS PANELS IN EIGHT LINES AS SHOWN, ② NO CUTTING OR FILLING ALLOWED OVER AREA OF DRAINFIELD.

Comments/Conditions:

INITIAL SITE SKETCH

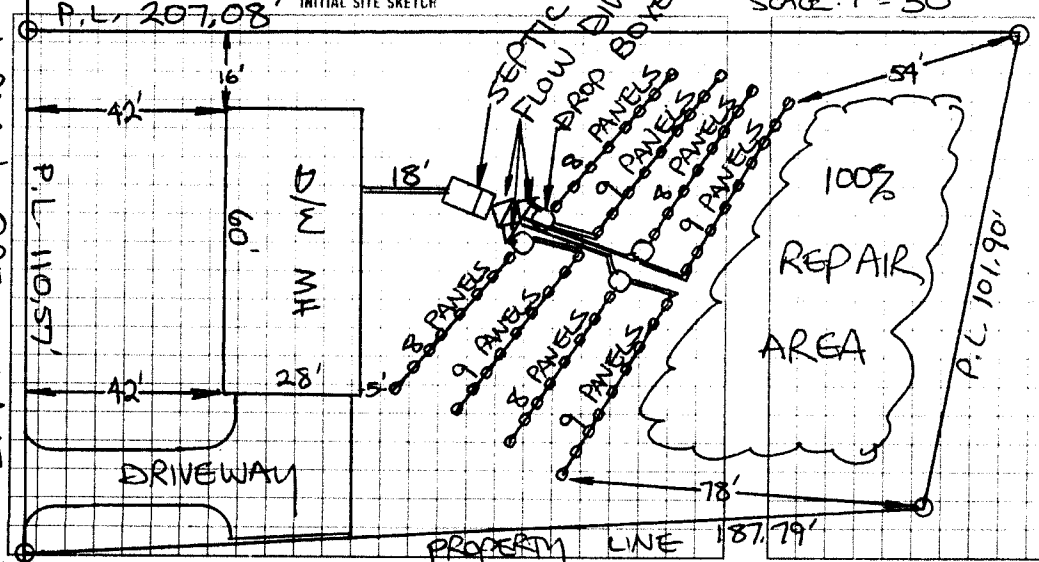

SCALE: 1" = 30'

AS BUILT SKETCH

SYSTEM INSTALLED ACCORDING TO INITIAL SITE SKETCH

JORDAN CREST LANE

I understand that this permit can be suspended or revoked if any false information is supplied toward securing the permit/any unauthorized changes are made to the site/any unauthorized changes are made in the installation of the system. Improvement Permit with plat valid without expiration. Improvement Permit with site plan valid for sixty months. Authorization to Construct is valid for a period equal to that of Improvement Permit – not to exceed sixty months.

Signed: Randy B. Ervin date 12-17-98 Installed by: SHANE JARRETT

Improvement Permit by: STEVE HEDRICK date 12-16-98 Operation Permit by: STEVE HEDRICK date 1-27-99

Authorization to Construct by: STEVE HEDRICK date 12-16-98 Existing System Inspection by: date

HEALTH DEPT. COPY: WHITE INSPECTION COPY (FINAL): GREEN OWNER COPY (FINAL): YELLOW INSPECTION COPY (INITIAL): PINK OWNER COPY (INITIAL): GOLD