IREDELL COUNTY HEALTH DEPARTMENT

STATESVILLE 704-878-5305 MOORESVILLE 704-664-5281

IMPROVEMENT PERMIT / AUTHORIZATION TO CONSTRUCT / OPERATION PERMIT / EXISTING SYSTEM INSPECTION

PERMIT# 104571 PIN# 3785-89-1342 DATE 12/2/02

OWNER OR CONTRACTOR Jerry Heger PHONE: Business (704) 585-6471 Home —

ADDRESS 906 Smith Farm Road Stony Point N.C. 28678

LOCATION I40 W @ Old Mtn Rd (R) County Line (L) Siding Crest @ end on Right

SUBDIVISION Victoria's Landmark BLOCK / SECTION — LOT 22 LOT AREA .49 Acre SITE CLASS I-S DESIGN FLOW 360 L.T.A.R. .35

Septic Tank: 4000 Gallons: STB 1012 Date 7-23-02
Pump Tank: — Gallons: PT — Date —
Pump Make: — Model — Serial No. —
Nitrification Field: No Fields 1 Square Feet 1029 Linear Feet 260
No Lines 4 Trench Width 36" Max Trench Bottom Depth 36" Gravel Depth NA

[X] New System [ ] Repair System Type: I, II, III, IV, V, VI
System Description: Gravity, 25% Reduction
Repair System Description: Pump Station, LPP
Maintenance Agreement Required: [ ] Yes [X] No

[ ] House/Mod. Home [X] Mobile Home [ ] Business [ ] Other
No. Bedrooms 3 No. Bathrooms 2 No. Employees —


[ ] Slab [X] Crawl Space [ ] Basement w/plumbing [ ] Basement wo/plumbing

Water Supply: [ ] Individual [X] Public [ ] Community

Comments/Conditions: (1) Install Lines on Contour (2) Maintain proper Set backs

Comments/Conditions: - Twist-Tite filter Installed
- S.T. Marker Installed
- Infiltrator Chambers Installed

INITIAL SITE SKETCH

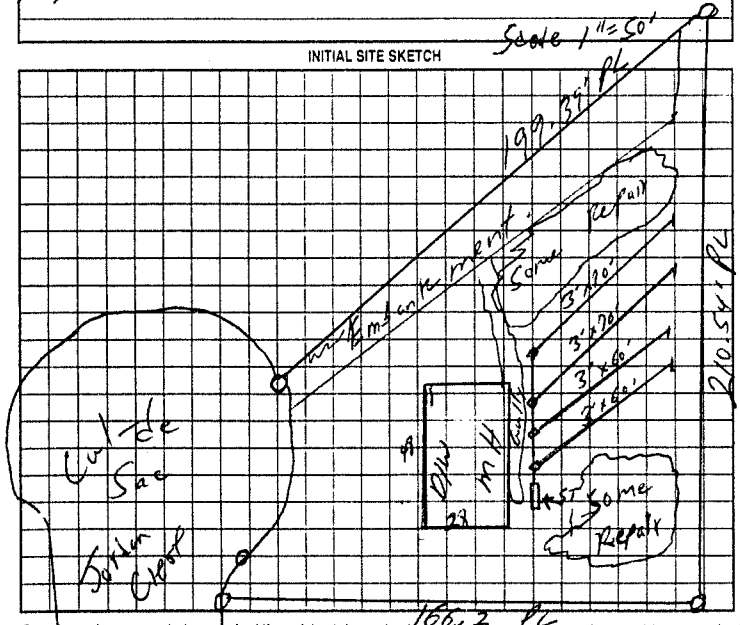

AS BUILT SKETCH

Installed As Shown Per Initial Site Sketch

Permit can be suspended or revoked if any false information is supplied toward securing the permit/any unauthorized changes are made to the site/any unauthorized changes are made in the installation of the system. Improvement Permit with plat valid without expiration. Improvement Permit with site plan valid for sixty months. Authorization to Construct is valid for a period equal to that of Improvement Permit – not to exceed sixty months.

Signed: Jody Thompson date 12/2/02 Installed by: Craig Thompson

Improvement Permit by: William O Johnson date 12/2/02 Operation Permit by: William O Johnson date 12/2/02

Authorization to Construct by: William O Johnson date 12/2/02 Existing System Inspection by: — date —

HEALTH DEPT. COPY: WHITE OWNER COPY (FINAL): YELLOW OWNER COPY (INITIAL): PINK