(CT)

IREDELL COUNTY HEALTH DEPARTMENT

STATESVILLE 704-878-5305 MOORESVILLE 704-664-5281

IMPROVEMENT PERMIT / AUTHORIZATION TO CONSTRUCT / OPERATION PERMIT / EXISTING SYSTEM INSPECTION

PERMIT# 116565 PIN# 3785-89-4506 DATE 11/20/03

OWNER OR CONTRACTOR Fleetwood of Troutman PHONE: Business (704) 400-7019 Home —

ADDRESS 1040 Charlotte Hwy Troutman, NC 28166

LOCATION I-40 W, R Old Nor Rd, R Co Line Rd, L Jordan Crest Lane on left at end.

SUBDIVISION Victoria Landmark BLOCK / SECTION 2 LOT 20 LOT AREA 1.737 Acres SITE CLASS. PS DESIGN FLOW 480 L.T.A.R. .25 gpd/ft²

Septic Tank: 1000 Gallons; STB 1012 Date 6/15/03
Pump Tank: — Gallons; PT — Date —
Pump Make: — Model — Serial No. —
Nitrification Field: No Fields 1 Square Feet 1391/1920 Linear Feet 480
No Lines Be 60 Trench Width 36" Max Trench Bottom Depth 30" Gravel Depth N/A

☒ New System ☐ Repair, System Type: I, II, III, IV, V, VI
System Description: Gravity, 25% Reduction
Repair System Description: Gravity, 25% Reduction
Maintenance Agreement Required: ☐ Yes ☐ No

☐ House/Mod. Home ☒ Mobile Home ☐ Business ☐ Other
No. Bedrooms 4 No. Bathrooms 2 No. Employees —


☐ Slab ☒ Crawl Space ☐ Basement w/plumbing ☐ Basement wo/plumbing

Water Supply: ☒ Individual ☐ Public ☐ Community


Comments:/Conditions: (1) Move surface drainage to side property line (2) Install (1) one flow divider tee and (7) seven drop boxes (3) Install lines on contour (4) Maintain proper setbacks

Comments:/Conditions: Tuff-Tite filter, septic tank marker, infiltrator chambers (77), installed as shown

INITIAL SITE SKETCH Scale 1"=60'

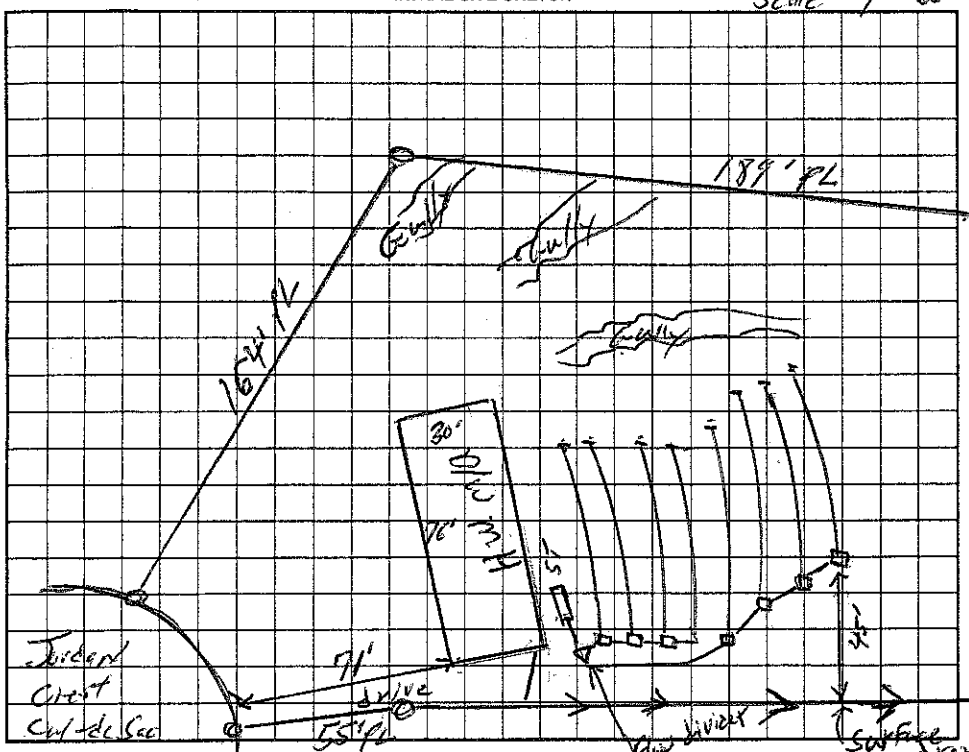

AS BUILT SKETCH

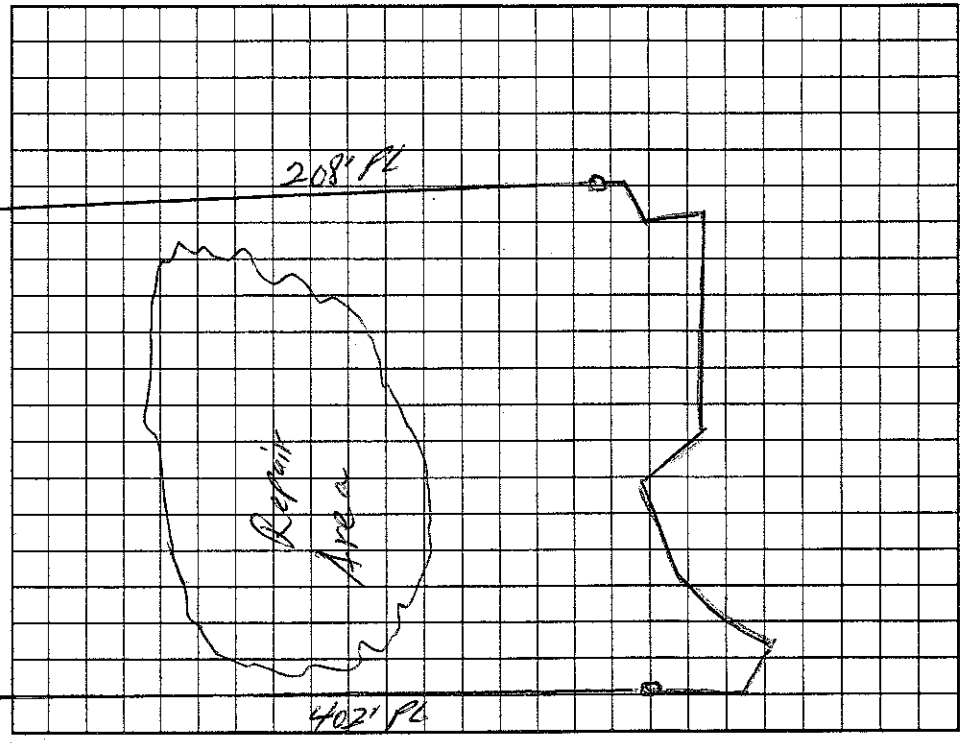

Permit can be suspended or revoked if any false information is supplied toward securing the permit/any unauthorized changes are made to the site/any unauthorized changes are made in the installation of the system. Improvement Permit with plat valid without expiration. Improvement Permit with site plan valid for sixty months. Authorization to Construct is valid for a period equal to that of Improvement Permit – not to exceed sixty months.

Signed: [signature] date 11/20/03 Installed by: Craig Thompson

Improvement Permit by: William O. Johnson date 11/20/03 Operation Permit by: Christopher M. Sherrill, RS date 12/3/03

Authorization to Construct by: William O. Johnson date 11/20/03 Existing System Inspection by: — date —

HEALTH DEPT. COPY: WHITE OWNER COPY (FINAL): YELLOW OWNER COPY (INITIAL): PINK