IREDELL COUNTY HEALTH DEPARTMENT

STATESVILLE 704-878-5305 MOORESVILLE 704-664-5281

IMPROVEMENT PERMIT / AUTHORIZATION TO CONSTRUCT / OPERATION PERMIT / EXISTING SYSTEM INSPECTION

PERMIT# REPAIR PIN# 3785-99-0937 DATE 8-16-06

OWNER OR APPLICANT ERNEST LEE GRIFFIN PHONE: Business Home 704-585-2730

ADDRESS 245 CAIN ROAD STONY POINT NC 28678-9463

LOCATION I-40 W, TR OLD MOUNTAIN ROAD, TL CAIN ROAD TO END ON LEFT.

SUBDIVISION BLOCK / SECTION LOT LOT AREA 1.01 ACRES SITE CLASS. PS DESIGN FLOW 360 L.T.A.R. 0.30 GPD/FT²

Septic Tank: 1000 Gallons; STB Date

Pump Tank: Gallons; PT Date

Pump Make: Model Serial No.

Nitrification Field: No Fields 1 Square Feet 600 Linear Feet 200

No Lines TWO Trench Width 36" Max Trench Bottom Depth 21"

☐ New System ☑ Repair ☐ Expansion System Type: I II III IV V VI

System Description:

Repair System Description: CONVENTIONAL GRAVITY

Maintenance Agreement Required: ☐ Yes ☑ No

Gravel Depth 12" ☑ Gravity ☐ Pressure

☐ House/Mod. Home ☑ Mobile Home ☐ Business ☐ Other

No. Bedrooms 3 No. Persons No. Employees


Water Supply: ☑ Individual ☐ Public ☐ Community WELL

☐ Slab ☑ Crawl Space ☐ Basement w/plumbing ☐ Basement wo/plumbing

Comments/Conditions: ① INSTALL NEW DISTRIBUTION BOX AT LOCATION SHOWN FEEDING OLD DRAINLINE FIRST. ② AN "ACCEPTED" SYSTEM MAY ALSO BE USED. ③ INSTALL LINES ON CONTOUR NO DEEPER THAN 21"

Comments/Conditions: ④ NECESSARY EASEMENT SHALL BE OBTAINED AND RECORDED WITH THE REGISTER of DEEDS PRIOR TO ISSUANCE of CONSTRUCTION AUTHORIZATION.

INITIAL SITE SKETCH

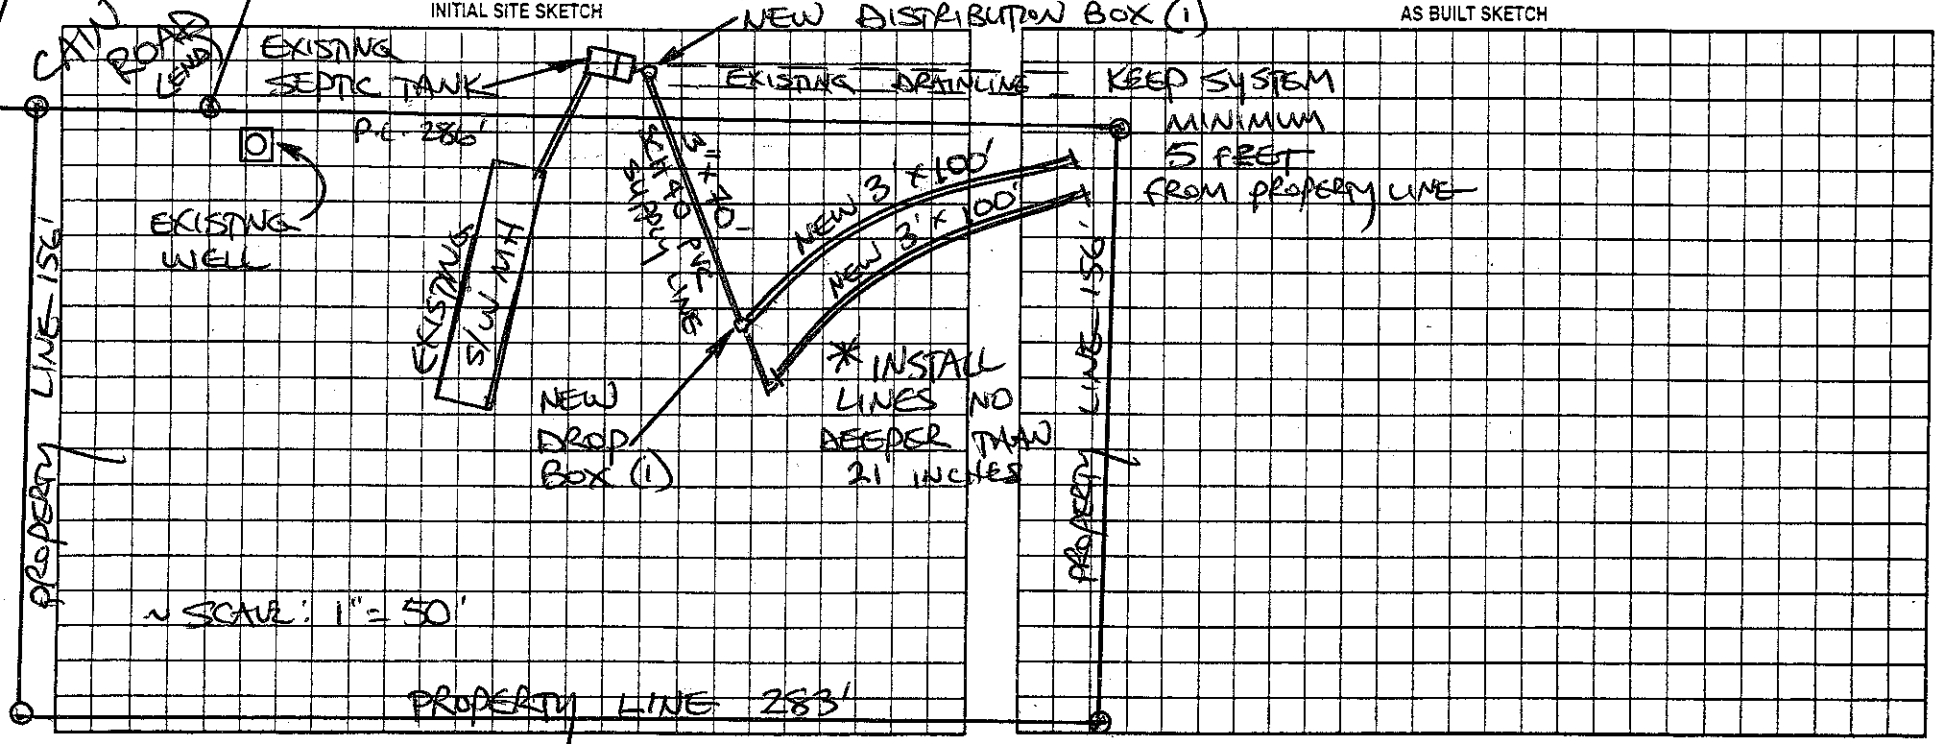

AS BUILT SKETCH

Permit can be suspended or revoked if any false information is supplied toward securing the permit/any unauthorized changes are made to the site/any unauthorized changes are made in the installation of the system. Improvement Permit with plat valid without expiration. ☐ Improvement Permit with site plan valid for sixty months ☑ Authorization to Construct is valid for a period equal to that of Improvement Permit – not to exceed sixty months.

Signed: Ernest L Griffin date 8-16-06 Installed by: CHARLIE BEAL

Improvement Permit by: STEVE HEDRICK date 8-16-06 Operation Permit by: date 8-22-06

Authorization to Construct by: STEVE HEDRICK date 8-17-06 Existing System Inspection by: date

HEALTH DEPT. COPY: WHITE OWNER COPY (FINAL): YELLOW OWNER COPY (INITIAL): PINK