IREDELL COUNTY HEALTH DEPARTMENT

Statesville Phone TR 3-7271

Mooresville Phone NO 3-1271

PERMIT TO INSTALL SEPTIC TANK

Permit NO. Orus Hellman

Permit Date July 13 19[illegible]

Owner Negro. man — Watts

Address [illegible] Co. Line Rd.

Installed By C Hoke

Address R2. 0

Location of Property Mt old mtn. Rd then Bradford Rd before Co. line left on Co. line Rd. 2nd on left.


Tank		Capacity		Length of Lines		Fixtures	
Block	( )	800	( )	150'	( )	No. of Baths	( )
Precast	(✓)	900	(✓)	175'	( )	Dishwasher	( )
Post		1000	( )	200'	( )	Garbage Grdr.	( )
		1100	( )	225'	( )	Auto-Washer	( )
		1200	( )	250'	( )	Other	( )
		Other		Other			

NOTIFY HEALTH DEPARTMENT AT LEAST EIGHT HOURS BEFORE TANK IS TO BE INSPECTED.

Final Inspection _____ 195_

Approved ( ) Disapproved ( )

Remarks NH for Washer — well 110' ft.

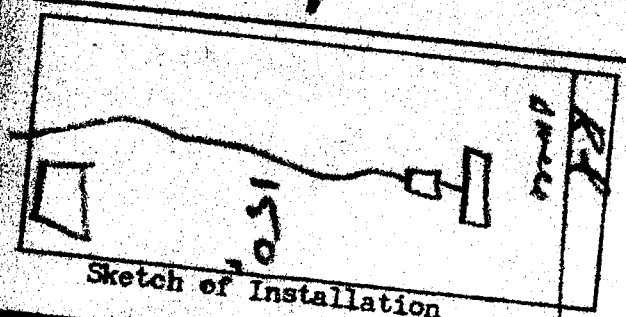

Sketch of Installation

Put

Sanitarian