IREDELL COUNTY HEALTH DEPARTMENT

STATESVILLE 704-878-5305 MOORESVILLE 704-664-5281

IMPROVEMENT PERMIT / AUTHORIZATION TO CONSTRUCT / OPERATION PERMIT / EXISTING SYSTEM INSPECTION

PERMIT# 83844 PIN# 3786828709 DATE Oct 6 99

OWNER OR CONTRACTOR Jeff Byers PHONE: Business Home 871 2622

ADDRESS 1027 Hunter St. Statesville

LOCATION N old Mt Zion ⓒ County Line on Left Apx ⅓ mile

SUBDIVISION BLOCK / SECTION LOT LOT AREA 3.99Ac SITE CLASS. P5 DESIGN FLOW 360 L.T.A.R. .3

Septic Tank: 1000 Gallons; STB 1012 Date 7 16 99
Pump Tank: Gallons; PT Date
Pump Make: Model Serial No.
Nitrification Field: No Fields 1 Square Feet 1200 Linear Feet 400
No Lines 5 @ 80' Trench Width 36" Max Trench Bottom Depth 36"

☒ New System ☐ Repair System Type: ☐ I ☒ II ☐ III, IV, V, VI
System Description: Conv GRAVITY
Repair System Description: Same pump Possible
Maintenance Agreement Required: ☐ Yes ☒ No
Gravel Depth 12"


☐ House/Mod. Home No. Bedrooms 3
☒ Mobile Home SW No. Bathrooms 2
☐ Business No. Employees
☐ Other
☐ Slab ☒ Crawl Space ☐ Basement w/plumbing ☐ Basement wo/plumbing

Water Supply: ☐ Individual ☒ Public ☐ Community


Comments/Conditions: LOCATE H_2O Line opposite side of drive
INSTALL on CONTOUR
Septic Tank AT LEAST 50% in undisturbed Soil

Comments/Conditions.

INITIAL SITE SKETCH

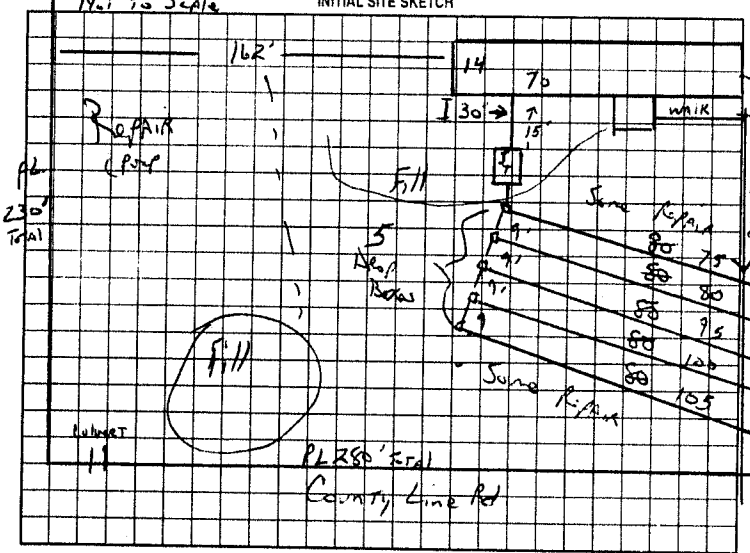

AS BUILT SKETCH

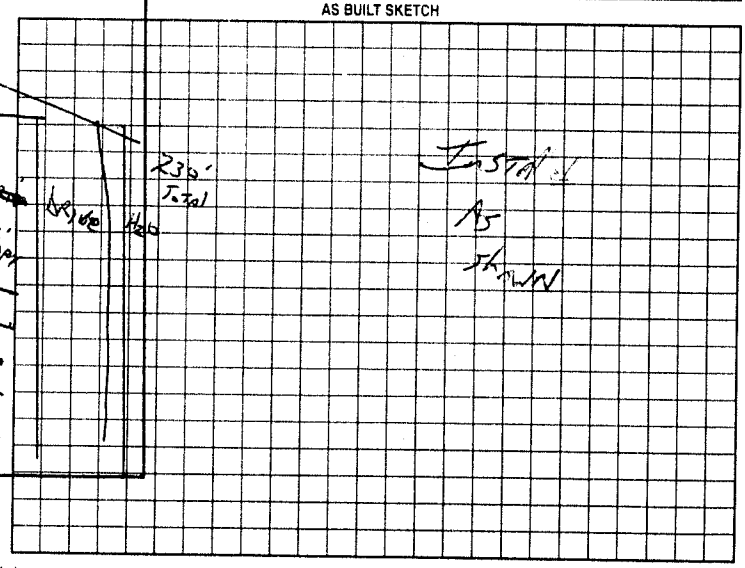

Permit can be suspended or revoked if any false information is supplied toward securing the permit/any unauthorized changes are made to the site/any unauthorized changes are made in the installation of the system. Improvement Permit with plat valid without expiration. Improvement Permit with site plan valid for sixty months. Authorization to Construct is valid for a period equal to that of Improvement Permit – not to exceed sixty months.

Signed: Jeff Byers date 10-6-99

Improvement Permit by: J. Potter date Oct 6 99

Authorization to Construct by: Jo Potter date Oct 6 99

Installed by: Wes Lytton

Operation Permit by: J. Potter date Nov 16 99

Existing System Inspection by: date

HEALTH DEPT COPY: WHITE OWNER COPY (FINAL) YELLOW OWNER COPY (INITIAL) PINK