IREDELL COUNTY HEALTH DEPARTMENT

STATESVILLE 704-878-5305 MOORESVILLE 704-664-5281

IMPROVEMENT PERMIT / AUTHORIZATION TO CONSTRUCT / OPERATION PERMIT / EXISTING SYSTEM INSPECTION

PERMIT# 092329 PIN# 379509 0951 DATE 4/5/01

OWNER OR CONTRACTOR Clyde Hall Enterprise PHONE: Business (704) 876-6847 Home —

ADDRESS P.O. Box 1556 Mooresville, NC 28115

LOCATION Hwy to I-40 (R) on mtn Rd, (L) Cain Rd, (R) Straw Road on Right

SUBDIVISION Cain Road Estates BLOCK / SECTION II LOT 17 LOT AREA .56 Acres SITE CLASS PS DESIGN FLOW 360 L.T.A.R. .3

Septic Tank: 1,000 Gallons; STB 1012 Date 6-12-01 — [X] New System [ ] Repair System Type: I, II, III, IV, V, VI — [ ] House/Mod. Home No. Bedrooms 3 — Water Supply: [ ] Individual

Pump Tank: — Gallons; PT — Date — System Description: Gravity, 25% Reduction — [X] Mobile Home No. Bathrooms 2 — [X] Public

Pump Make: — Model equivalent to Serial No — Repair System Description: Gravity, 25% Reduction — [ ] Business No. Employees — [ ] Community


Nitrification Field: No Fields 1 Square Feet 1,200 Linear Feet 300' — Maintenance Agreement Required: [ ] Yes [X] No — [ ] Other —

No Lines 5 @ 60' Trench Width 36" Max Trench Bottom Depth 30" Gravel Depth — — [ ] Slab [X] Crawl Space [ ] Basement w/plumbing [ ] Basement wo/plumbing


Comments/Conditions: ① Install 5 lines @ 60' ② Keep System 10 Ft from Property Lines ③ Install 25% Reduction System using Chambers OR HDES Sections on Contour

Comments/Conditions — poly rok Filter — Septic Tank marker — 50 Infiltrator Chambers (4 lines) 4, 4, 10, 7, 9 (5th Line)

INITIAL SITE SKETCH

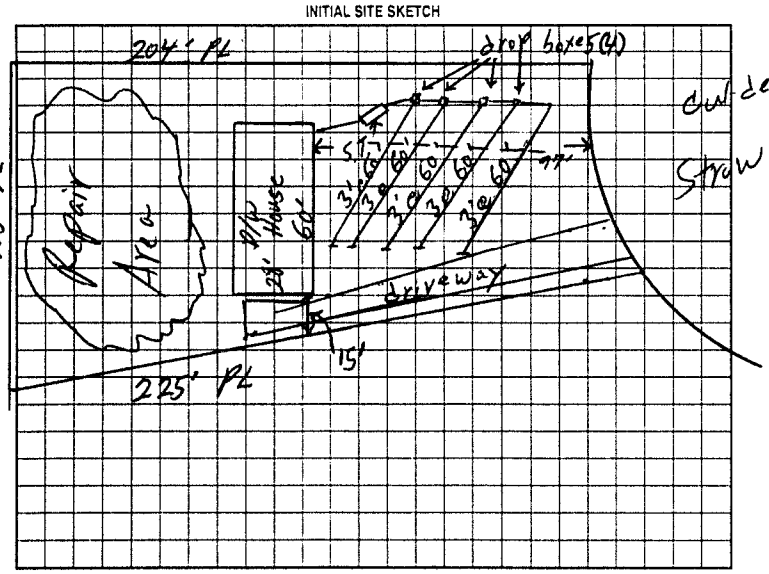

AS BUILT SKETCH

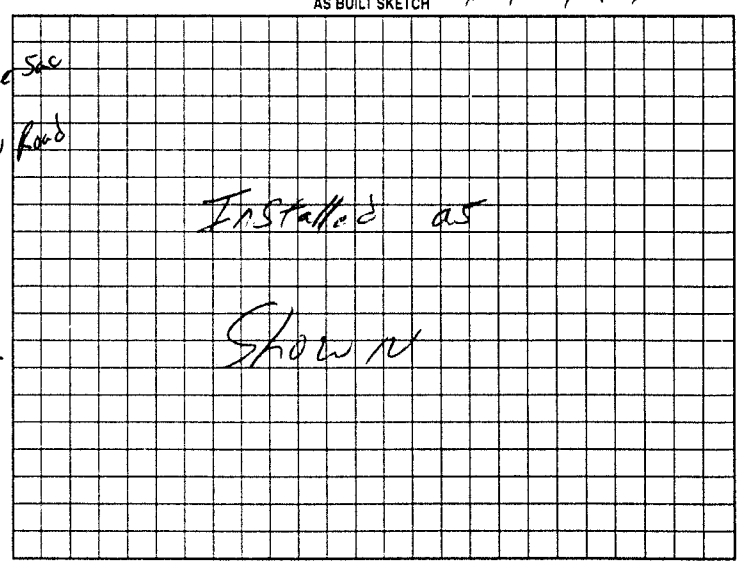

Permit can be suspended or revoked if any false information is supplied toward securing the permit/any unauthorized changes are made to the site/any unauthorized changes are made in the installation of the system. Improvement Permit with plat valid without expiration. Improvement Permit with site plan valid for sixty months. Authorization to Construct is valid for a period equal to that of Improvement Permit – not to exceed sixty months.

Signed: James H Combs date 3/11/01 Installed by: Tommy Cotherman Grading

Improvement Permit by: William O. Johnson RSI date 4/5/01 Operation Permit by: William O. Johnson date 4/23/01

Authorization to Construct by: William O. Johnson RSI date 4/5/01 Existing System Inspection by: — date —

HEALTH DEPT COPY WHITE OWNER COPY (FINAL) YELLOW OWNER COPY (INITIAL) PINK