IREDELL COUNTY HEALTH DEPARTMENT

STATESVILLE 704-878-5305 MOORESVILLE 704-664-5281

IMPROVEMENT PERMIT / AUTHORIZATION TO CONSTRUCT / OPERATION PERMIT / EXISTING SYSTEM INSPECTION

PERMIT# 92325 PIN# 3795 09 0951 DJ DATE 12/29/00

OWNER OR CONTRACTOR CLYDE HALL ENT PHONE: Business 876-6847 Home

ADDRESS PO BOX 3397 MOORESVILLE NC 28117

LOCATION OLD MOUNTAIN RD - TL CAEN RD - IN CURVE ON LT.

SUBDIVISION CAEN RD ESTATES BLOCK / SECTION LOT 12 LOT AREA .761C SITE CLASS ES DESIGN FLOW 360GPD L.T.A.R. .360/1.72

Septic Tank: 1000 Gallons; STB 1012 Date 2-14-01
Pump Tank: Gallons; PT Date
Pump Make: Model Serial No.
Nitrification Field: No Fields 1 Square Feet 1200 Linear Feet 400
No Lines 4@100' Trench Width 36" Max Trench Bottom Depth 36"

☑ New System ☐ Repair System Type: I (II) III. IV. V. VI
System Description: GRAVITY CONVENTIONAL
Repair System Description: GRAVITY INNOVATIVE
Maintenance Agreement Required: ☐ Yes ☑ No
Gravel Depth 12"

☑ House/Mod. Home No. Bedrooms 3
☑ Mobile Home No. Bathrooms 2
☐ Business No. Employees
☐ Other


☐ Slab ☑ Crawl Space ☐ Basement w/plumbing ☐ Basement wo/plumbing

Water Supply: ☐ Individual ☑ Public ☐ Community


Comments/Conditions:

Comments/Conditions: - poly Lok filter Installed
- Septic Tank marker Installed

INITIAL SITE SKETCH

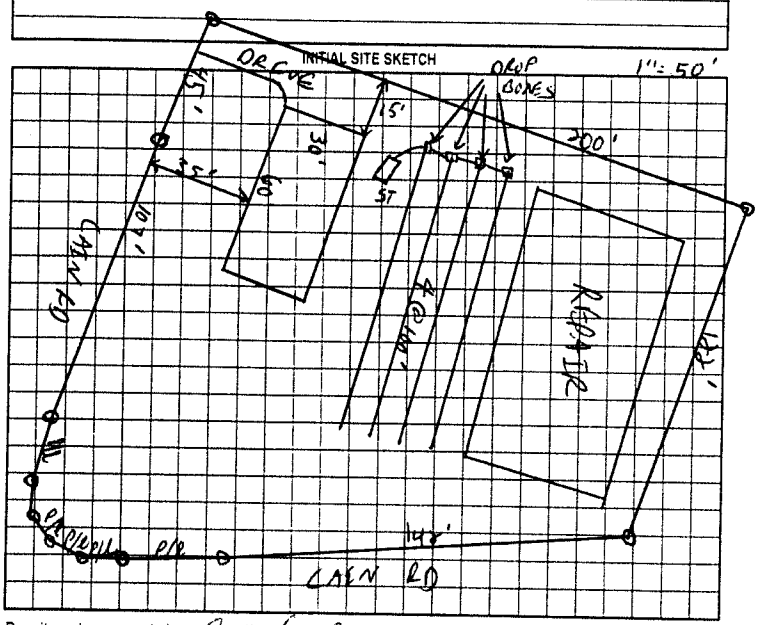

AS BUILT SKETCH

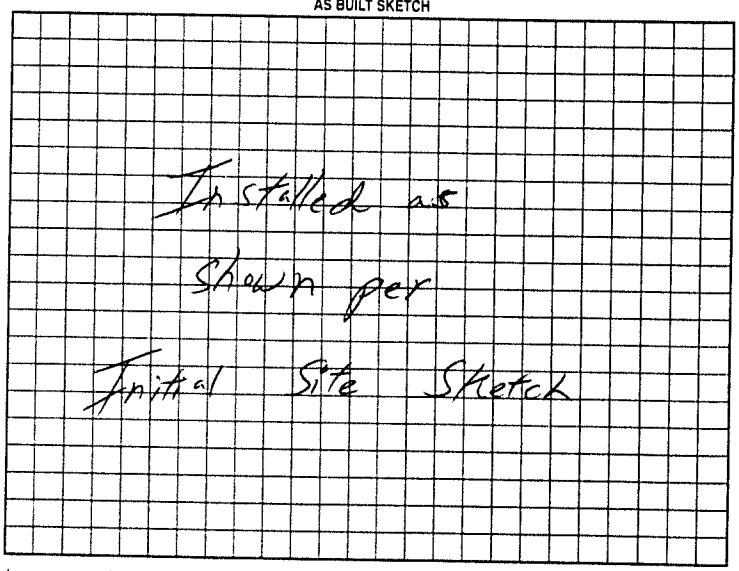

Permit can be suspended or revoked if any false information is supplied toward securing the permit/any unauthorized changes are made to the site/any unauthorized changes are made in the installation of the system. Improvement Permit with plat valid without expiration. Improvement Permit with site plan valid for sixty months. Authorization to Construct is valid for a period equal to that of Improvement Permit - not to exceed sixty months.

Signed: date

Improvement Permit by: date 12/29/00

Authorization to Construct by: date 12/29/00

Installed by: Tommy Cotheron

Operation Permit by: William C. Johnson date 5/25/01

Existing System Inspection by: date

HEALTH DEPT COPY WHITE OWNER COPY (FINAL) YELLOW OWNER COPY (INITIAL) PINK