IREDELL COUNTY HEALTH DEPARTMENT

STATESVILLE 704-878-5305 MOORESVILLE 704-664-5281

IMPROVEMENT PERMIT / AUTHORIZATION TO CONSTRUCT / OPERATION PERMIT / EXISTING SYSTEM INSPECTION

PERMIT# 92331 PIN# 3795040951 PT DATE 12/29/00

OWNER OR CONTRACTOR CLYDE HALL ENT. PHONE: Business 876-6847 Home

ADDRESS PO BOX 3397 MOORESVILLE NC 28117

LOCATION OLD MOUNTAIN RD - TL CAEN RD - TL STRAW - AT END ON LT

SUBDIVISION CAIN ESTATES BLOCK / SECTION II LOT 20 LOT AREA 1.071AC SITE CLASS. PS DESIGN FLOW 360GPD L.T.A.R. ~.25GPD/FT²

Septic Tank: 1000 Gallons: STB 1072 Date 11-3-00
Pump Tank: Gallons: PT Date
Pump Make: Model Serial No.
Nitrification Field: No Fields 1 Square Feet 500 Linear Feet 250
No Lines 5@50' Trench Width 24" Max Trench Bottom Depth 36" Gravel Depth N/A

☑ New System ☐ Repair System Type: I. II. (III.) IV. V. VI
System Description: GRAVITY FANFC
Repair System Description: SAME
Maintenance Agreement Required: ☐ Yes ☑ No

☑ House/Mod. Home ☑ Mobile Home ☐ Business ☐ Other
No. Bedrooms 3 No. Bathrooms 2 No. Employees


☐ Slab ☐ Crawl Space ☐ Basement w/plumbing ☐ Basement wo/plumbing

Water Supply: ☐ Individual ☑ Public ☐ Community


Comments/Conditions: 1"=50'

Comments/Conditions: - Poly Lok Filter Installed
- Septic Tank marker Installed

INITIAL SITE SKETCH

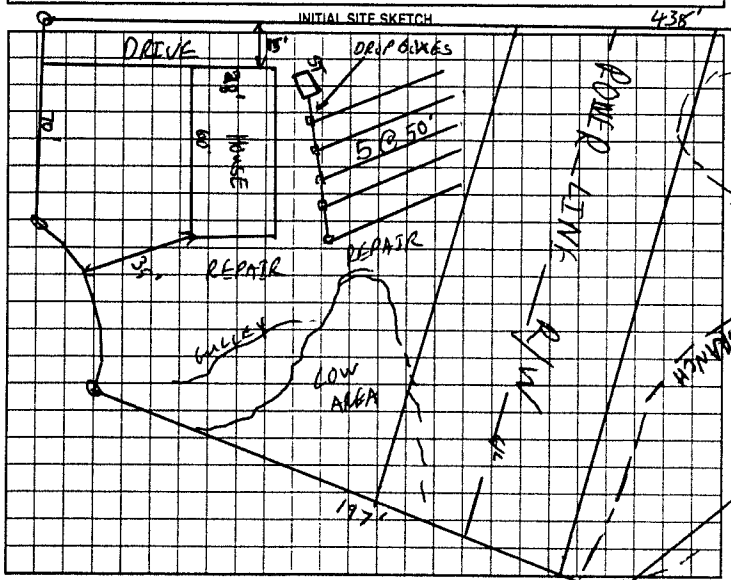

AS BUILT SKETCH

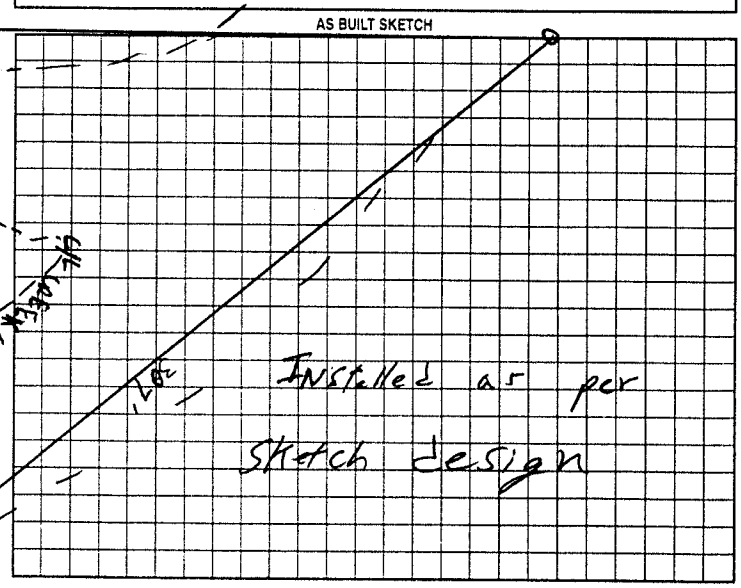

Permit can be suspended or revoked if any false information is supplied toward securing the permit/any unauthorized changes are made to the site/any unauthorized changes are made in the installation of the system. Improvement Permit with plat valid without expiration. Improvement Permit with site plan valid for sixty months. Authorization to Construct is valid for a period equal to that of Improvement Permit – not to exceed sixty months.

Signed: N B Strickland date

Improvement Permit by: C. Blythe RS date 12/29/00

Authorization to Construct by: C. Blythe RS date 12/29/00

Installed by: Tommy Cothren

Operation Permit by: William A Johnson date 3/14/01

Existing System Inspection by: date

HEALTH DEPT COPY WHITE OWNER COPY (FINAL) YELLOW OWNER COPY (INITIAL) PINK