This Permit was previously issued Permit # 11/13/01.

IREDELL COUNTY HEALTH DEPARTMENT

STATESVILLE 704-878-5305 or MOORESVILLE 704-664-5281

IMPROVEMENT PERMIT / AUTHORIZATION TO CONSTRUCT / OPERATION PERMIT / EXISTING SYSTEM INSPECTION

PERMIT# 095662 PIN# 3786-90-6358 DATE 12/19/02

OWNER OR CONTRACTOR Clyde Hall Enterprises PHONE Business (704) 450-6481 Home Tim Combs

ADDRESS P.O. Box 3392 Mooresville NC 28117

LOCATION I-40 W. to Old mtn Rd (L) Cain Rd (L) Straw Drive on Left.

SUBDIVISION Cain Rd BLOCK / SECTION — LOT 21 LOT AREA 1.25 Ac. SITE CLASS 5 DESIGN FLOW 360 L.T.A.R. .25 gpd/ft²

Septic Tank: 1,000 Gallons: STB 1012 Date 6-30-02
Pump Tank: Gallons: PT Date
Pump Make: Model equiv. Serial No
Nitrification Field: No Fields 1 Square Feet 1440 Linear Feet 360'
No Lines 4@90' Trench Width 3 Ft Max Trench Bottom Depth 36" Gravel Depth —

[X] New System [ ] Repair System Type: I, II, (III) IV, V, VI
System Description: Gravity, 25% Reduction
Repair System Description: Gravity / Pump, Solid Collection
Maintenance Agreement Required: [ ] Yes [X] No

[ ] House/Mod. Home [X] Mobile Home [ ] Business [ ] Other
No. Bedrooms 3 No. Bathrooms 2 No. Employees


Water Supply: [ ] Individual [X] Public [ ] Community

[ ] Slab [X] Crawl Space [ ] Basement w/plumbing [ ] Basement wo/plumbing


Comments/Conditions: ① Do Not Install Gutter Lines ② Install Lines on Contour ③ Keep System up hill as far as possible to allow for maximum repair

Comments/Conditions: - 360 Ft of EZ Flow installed
- Tuff Tite Filter Installed
- S.T. Marker Installed
- mH not on lot at time of Installation 12/19/02

INITIAL SITE SKETCH (Not to Scale)

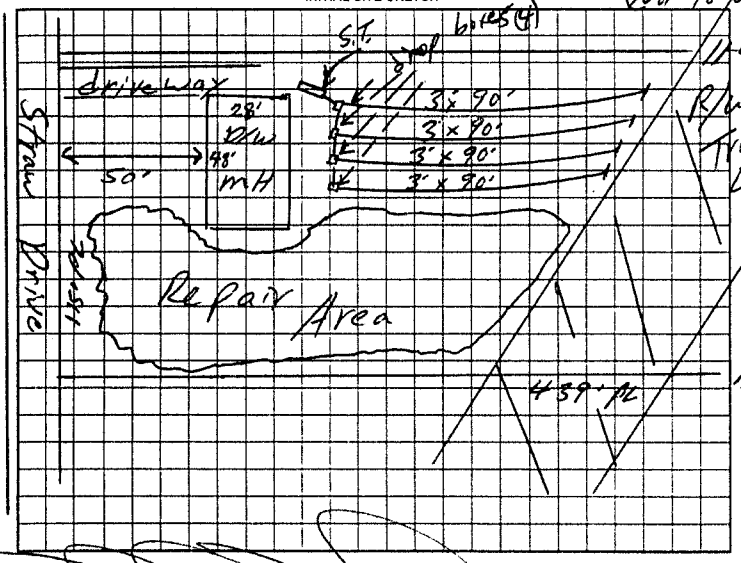

AS BUILT SKETCH

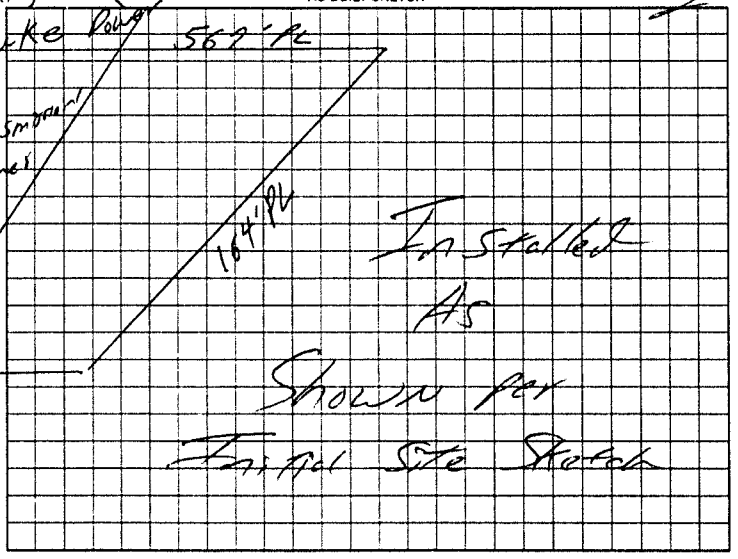

Permit can be suspended or revoked if any false information is supplied toward securing the permit, any unauthorized changes are made to the site, any unauthorized changes are made in the installation of the system. Improvement Permit with plot valid without expiration. Improvement Permit with site plan valid for sixty months. Authorization to Construct is valid for a period equal to that of Improvement Permit – not to exceed sixty months

Signed: date 12/30/02 installed by A-1 Backhoe

Improvement Permit by: William O. Johnson date 12/19/02 Operation Permit by: William O. Johnson date 12/24/02

Authorization to Construct by: William O. Johnson date 12/19/02 Existing System Inspection by: date

HEALTH DEPT COPY: WHITE OWNER COPY (FINAL): YELLOW OWNER COPY (INITIAL): PINK