11:30 TC Cathren

IREDELL COUNTY HEALTH DEPARTMENT

STATESVILLE 704-878-5305 MOORESVILLE 704-664-5281

IMPROVEMENT PERMIT / AUTHORIZATION TO CONSTRUCT / OPERATION PERMIT / EXISTING SYSTEM INSPECTION

PERMIT# 89470 PIN# 3795090951 PT. DATE 6/13/00

OWNER OR CONTRACTOR CLYDE HALL ENT PHONE: Business 664-6400 Home

ADDRESS PO BOX 1556 MOORESVILLE NC 28115

LOCATION OLD MTN RD - TL CAIN & TL STRAW 3RD ON LT

SUBDIVISION CAIN PO EST BLOCK / SECTION 2 LOT 22 LOT AREA 1.14AC SITE CLASS PS DESIGN FLOW 360GPD L.T.A.R. .30 PD/LTAR

Septic Tank: 1000 Gallons: STB 1007 Date 6 12 00

Pump Tank: Gallons: PT Date

Pump Make: Model Serial No.

Nitrification Field: No Fields 1 Square Feet 1200 Linear Feet 400

No Lines 5@80' Trench Width 36" Max Trench Bottom Depth 30" Gravel Depth 12"

☑ New System ☐ Repair System Type: I, II, III, IV, V, VI

System Description: GRAVITY CONVENTIONAL

Repair System Description: GRAVITY INNOVATIVE

Maintenance Agreement Required: ☐ Yes ☑ No

☐ House/Mod. Home ☑ Mobile Home ☐ Business ☐ Other

No. Bedrooms 3 No. Bathrooms 3 No. Employees


☐ Slab ☑ Crawl Space ☐ Basement w/plumbing ☐ Basement wo/plumbing

Water Supply: ☐ Individual ☐ Public ☐ Community

Comments/Conditions:


Comments/Conditions:

INITIAL SITE SKETCH 1"=50'

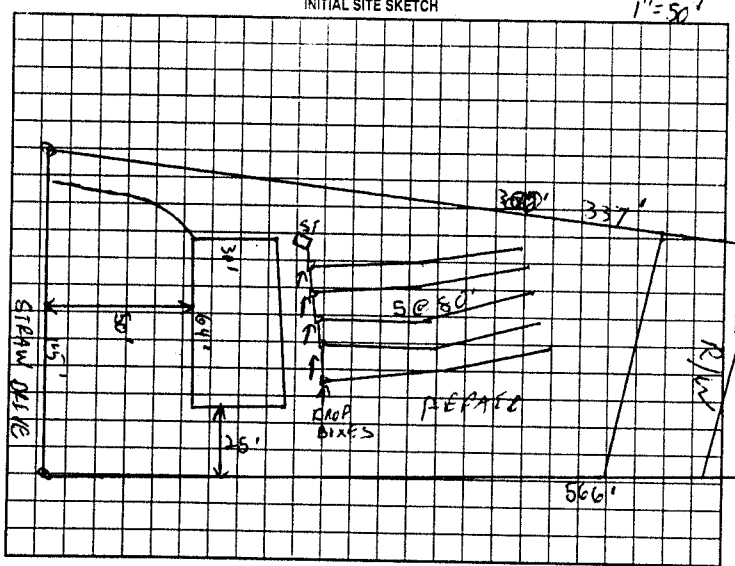

AS BUILT SKETCH

Installed as System Designed

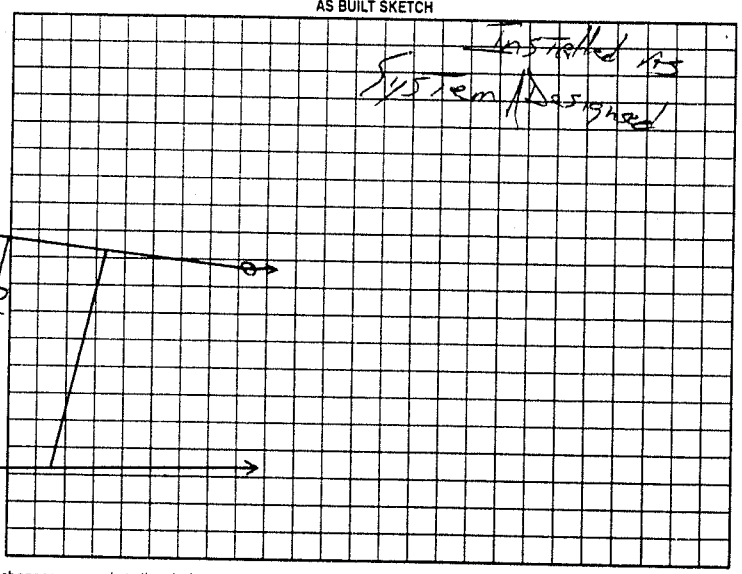

Permit can be suspended or revoked if any false information is supplied toward securing the permit/any unauthorized changes are made to the site/any unauthorized changes are made in the installation of the system. Improvement Permit with plat valid without expiration. Improvement Permit with site plan valid for sixty months. Authorization to Construct is valid for a period equal to that of Improvement Permit – not to exceed sixty months.

Signed: Ben Stikeleather date 6-14-2000 Installed by: Tommy Cathren

Improvement Permit by: CS date 6/13/00 Operation Permit by: JC Potter date 7/28/00

Authorization to Construct by: CS date 6/13/00 Existing System Inspection by: date

HEALTH DEPT. COPY: WHITE OWNER COPY (FINAL): YELLOW OWNER COPY (INITIAL): PINK