IREDELL COUNTY HEALTH DEPARTMENT

STATESVILLE 704-878-5305 MOORESVILLE 704-664-5281

IMPROVEMENT PERMIT / AUTHORIZATION TO CONSTRUCT / OPERATION PERMIT / EXISTING SYSTEM INSPEC

PERMIT# 89471 PIN# 3795040951 PT DATE 6/13/00

OWNER OR CONTRACTOR CLYDE HALL ENT PHONE: Business 664-6400 Home

ADDRESS PO BOX 1556 MOORESVILLE, NC 28115

LOCATION OLD MT RD. TL CAIN RD. TL STRAW DR. 2nd ON LT

SUBDIVISION CAIN RD BLOCK / SECTION 2 LOT 23 LOT AREA 1.24AC SITE CLASS RS DESIGN FLOW 360GPD L.T.A.R. .3 gpd/ft²

Septic Tank: 1000 Gallons; STB 1012 Date 7-22-00
Pump Tank: Gallons; PT Date
Pump Make: Model Serial No.
Nitrification Field: No Fields 1 Square Feet 1200 Linear Feet 400
No Lines 4@100' Trench Width 36" Max Trench Bottom Depth 30"

☑ New System ☐ Repair System Type: I II III IV V VI
System Description: GRAVITY CONVENTIONAL
Repair System Description: GRAVITY INNOVATIVE
Maintenance Agreement Required: ☐ Yes ☑ No
Gravel Depth 12"


☐ House/Mod Home No. Bedrooms 3
☑ Mobile Home No. Bathrooms 2
☐ Business No. Employees
☐ Other
☐ Slab ☑ Crawl Space ☐ Basement w/plumbing ☐ Basement wo/plumbing

Water Supply: ☐ Individual ☑ Public ☐ Community


Comments/Conditions:

Comments/Conditions: - Poly Lok Filter Installed
- Tank Marker Installed

INITIAL SITE SKETCH

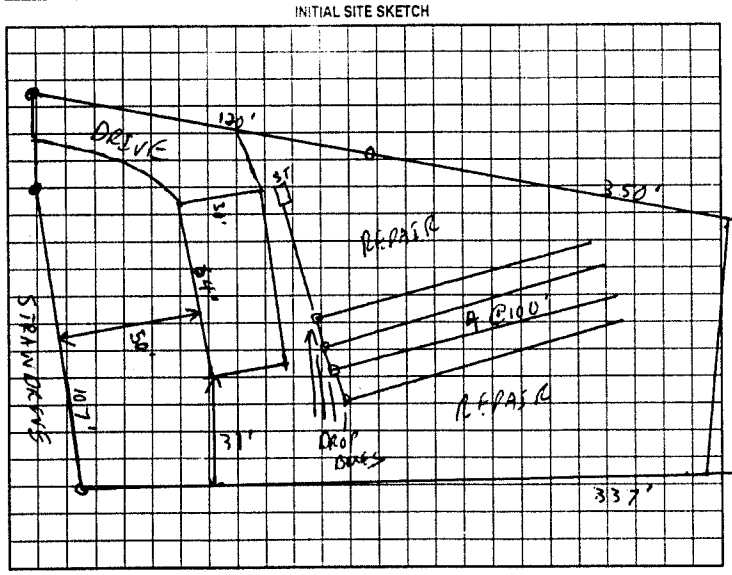

AS BUILT SKETCH

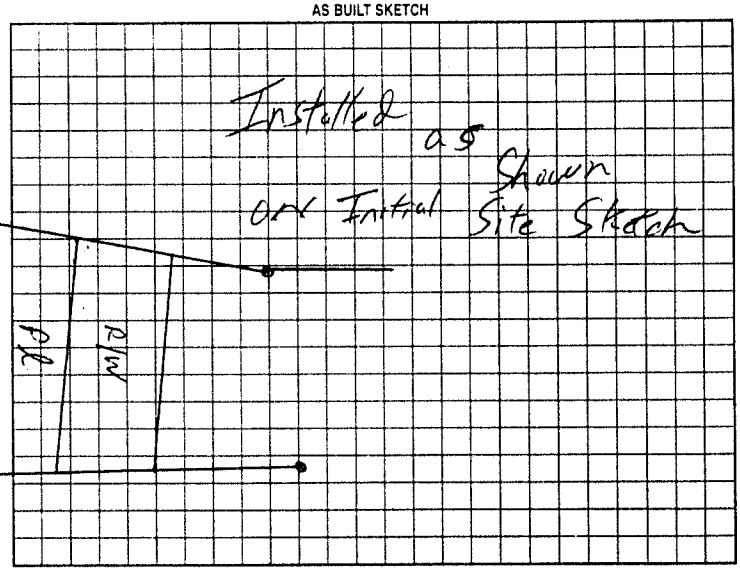

Permit can be suspended or revoked if any false information is supplied toward securing the permit/any unauthorized changes are made to the site/any unauthorized changes are made in the installation of the system. Improvement Permit with plat valid without expiration. Improvement Permit with site plan valid for sixty months. Authorization to Construct is valid for a period equal to that of Improvement Permit – not to exceed sixty months.

Signed: Ben Stikeleather date 6-14-2000 Installed by: Tommy Cathren

Improvement Permit by: C. Boyce RS date 6/13/00 Operation Permit by: William O. Johnson RSI date 3-28-01

Authorization to Construct by: C. Boyce RS date 6/13/00 Existing System Inspection by: date

HEALTH DEPT. COPY WHITE OWNER COPY (FINAL) YELLOW OWNER COPY (INITIAL) PINK