IREDELL COUNTY HEALTH DEPARTMENT

STATESVILLE 704-878-5305 MOORESVILLE 704-664-5281

IMPROVEMENT PERMIT / AUTHORIZATION TO CONSTRUCT / OPERATION PERMIT / EXISTING SYSTEM INSPECTION

PERMIT# 81605 PIN# 3795090951 DATE June 11, 99

OWNER OR CONTRACTOR Clyde Hall Ent. PHONE: Business 704 664 6400 Home

ADDRESS PO Box 3397 Mooresville NC

LOCATION Old NT Rd North @ Cain Rd on Left 1st or 1st curve

SUBDIVISION Cain Rd Est BLOCK / SECTION LOT 10 LOT AREA .56 SITE CLASS. 1S DESIGN FLOW 360 L.T.A.R. .3

Septic Tank: 1000 Gallons; STB 1012 Date 6 14 99
Pump Tank: Gallons; PT Date
Pump Make: Model Serial No.
Nitrification Field: No Fields 1 Square Feet 1200 Linear Feet 400
No Lines 5 @ 80 Trench Width 36" Max Trench Bottom Depth 36"

☒ New System ☐ Repair System Type: I. II. III. IV. V. VI
System Description: Conv. Gravity
Repair System Description: 5 - 25% Reduction Gravity
Maintenance Agreement Required: ☐ Yes ☒ No
Gravel Depth 12" ☐ Slab ☒ Crawl Space ☐ Basement w/plumbing ☐ Basement wo/plumbing


☐ House/Mod. Home No. Bedrooms 3
☒ Mobile Home S&W No. Bathrooms 2
☐ Business No. Employees
☐ Other

Water Supply: ☐ Individual ☒ Public ☐ Community


Comments/Conditions: No parking over Septic
Call 929 2030 for Final

Comments/Conditions

INITIAL SITE SKETCH

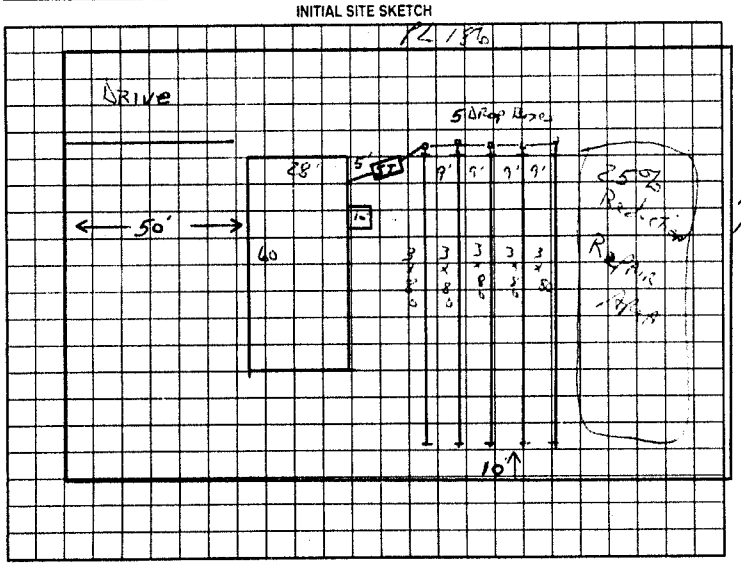

AS BUILT SKETCH

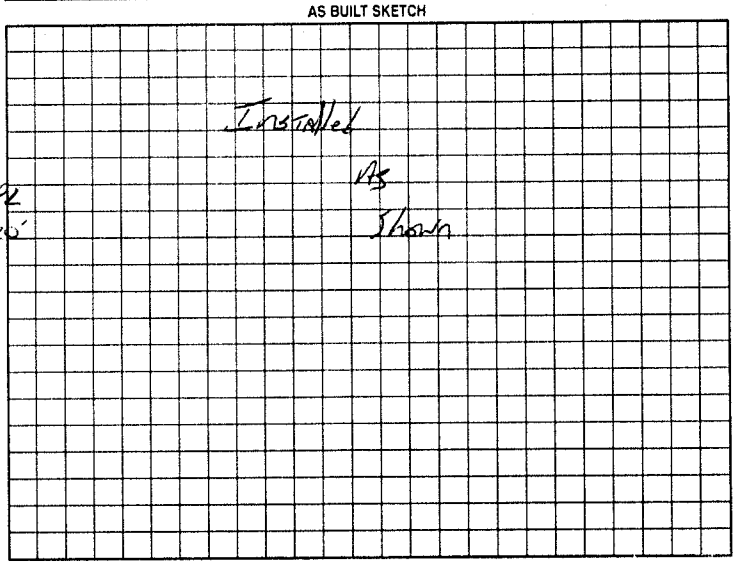

Permit can be suspended or revoked if any false information is supplied toward securing the permit/any unauthorized changes are made to the site/any unauthorized changes are made in the installation of the system. Improvement Permit with plat valid without expiration. Improvement Permit with site plan valid for sixty months. Authorization to Construct is valid for a period equal to that of Improvement Permit - not to exceed sixty months.

Signed: Petitioner or Agent date 6/14/99
Improvement Permit by: Lee Potter date 6 11 99
Authorization to Construct by: Lee Potter date 6 11 99

Installed by: C & W Grading
Operation Permit by: Lee Potter date Aug 2001
Existing System Inspection by: date

HEALTH DEPT. COPY: WHITE OWNER COPY (FINAL) YELLOW OWNER COPY (INITIAL) PINK