IREDELL COUNTY HEALTH DEPARTMENT

STATESVILLE 704-878-5305 MOORESVILLE 704-664-5281

IMPROVEMENT PERMIT / AUTHORIZATION TO CONSTRUCT / OPERATION PERMIT / EXISTING SYSTEM INSPECTION

PERMIT# 84164 PIN# 3795 09 0951 DATE 10-15-99

OWNER OR CONTRACTOR Clyde Hall Enterprizes PHONE: Business 664-6400 Home

ADDRESS PO Box 1556 Mooresville

LOCATION Old Mtn Road Turn Cain Rd on left

SUBDIVISION Cain Rd Est. BLOCK / SECTION 1 LOT 9 LOT AREA 1.84 acres SITE CLASS PS DESIGN FLOW 360 L.T.A.R. .22

Septic Tank: 1000 Gallons: STB 1012 Date 7-22-00
Pump Tank: Gallons; PT Date
Pump Make: Model Serial No.
Nitrification Field: No Fields 1 Square Feet 1620 Linear Feet 540
No Lines 6 Trench Width 36" Max Trench Bottom Depth 24" Gravel Depth 12"

☑ New System ☐ Repair System Type: I ⓘ III. IV. V. VI
System Description: Conv. Gravity
Repair System Description: Gravity 25% Reduction
Maintenance Agreement Required: ☐ Yes ☑ No


☐ House/Mod. Home ☑ Mobile Home ☐ Business ☐ Other
No. Bedrooms 3 No. Bathrooms 2 No. Employees

☐ Slab ☑ Crawl Space ☐ Basement w/plumbing ☐ Basement wo/plumbing

Water Supply: ☐ Individual ☑ Public ☐ Community


Comments:/Conditions:

INITIAL SITE SKETCH

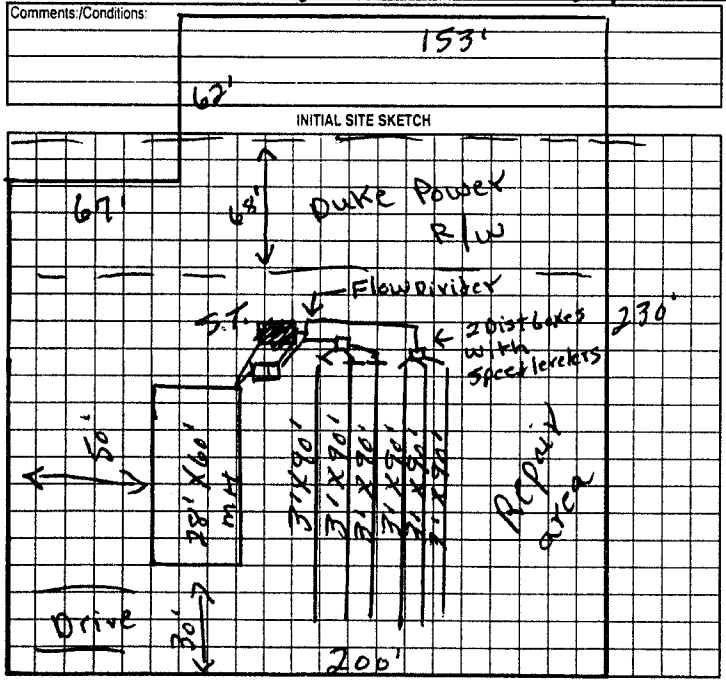

Comments:/Conditions: SEPTIC TANK W/ MARKER INSTALLED USING "POLYLOK" FILTER

AS BUILT SKETCH

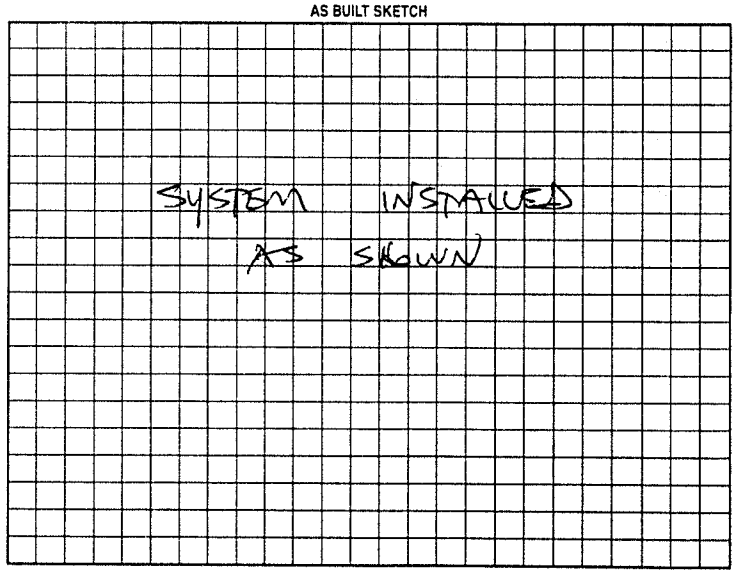

Permit can be suspended or revoked if any false information is supplied toward securing the permit/any unauthorized changes are made to the site/any unauthorized changes are made in the installation of the system. Improvement Permit with plat valid without expiration. Improvement Permit with site plan valid for sixty months. Authorization to Construct is valid for a period equal to that of Improvement Permit – not to exceed sixty months.

~~Signed~~: Barbara Southern date 2/4/00 Installed by: TOMMY COTHREN

Improvement Permit by: P. C. Moore date 10-15-99 Operation Permit by: STEVE HEDRICK date 12-7-00

Authorization to Construct by: P. C. Moore date 10-15-99 Existing System Inspection by: date

HEALTH DEPT. COPY: WHITE OWNER COPY (FINAL): YELLOW OWNER COPY (INITIAL): PINK