IREDELL COUNTY HEALTH DEPARTMENT

STATESVILLE 704-878-5305 MOORESVILLE 704-664-5281

IMPROVEMENT PERMIT / AUTHORIZATION TO CONSTRUCT / OPERATION PERMIT / EXISTING SYSTEM INSPECTION

PERMIT# / PIN# 3792-14-9068 DATE 6-2-04

OWNER OR CONTRACTOR THEODORE GOLDMAN PHONE: Business Home 704-872-8072

ADDRESS 112 PIERCE WOODS DR STATESVILLE NC 28677

LOCATION TO WEST ON PIERCE WOODS DR 1ST DRIVE ON RT

SUBDIVISION BLOCK / SECTION LOT LOT AREA 4.54 AC SITE CLASS. PS DESIGN FLOW 360 L.T.A.R. EXISTING RECORD

Septic Tank: 1250 Gallons; STB Date

Pump Tank: Gallons; PT Date

Pump Make: Model Serial No.

Nitrification Field: No Fields 1 Square Feet 600 Linear Feet 300'

No Lines 3 x 100' Trench Width 36" Max Trench Bottom Depth 36" Gravel Depth 12"

☒ New System ☒ Repair System Type: I, (II), III, IV, V, VI

System Description: CONV GRAV

Repair System Description:

Maintenance Agreement Required: ☐ Yes ☒ No

☐ House/Mod. Home No. Bedrooms 3

☒ Mobile Home No. Bathrooms 1.5

☐ Business No. Employees

☐ Other


☐ Slab ☒ Crawl Space ☐ Basement w/plumbing ☐ Basement wo/plumbing

Water Supply: ☐ Individual ☒ Public ☐ Community


Comments:/Conditions: (1) CALL PRIOR TO INSTALLATION FOR CONSULTATIVE VISIT. DPST MAY / MAYBE IF EQUAL FLOW CAN'T BE ACHIEVED OR IF IT WILL NOT BACK UP TO THE BOX. (2) WOODS / UNDERGROWTH

Comments:/Conditions: WILL HAVE TO BE CLEARED OUT. (3) INSTALL LINES ON CONTOURS (4) THIS PERMIT SERVES AS NOTICE OF VIOLATION & MUST BE REPAIRED WITHIN 30 DAYS.

INITIAL SITE SKETCH

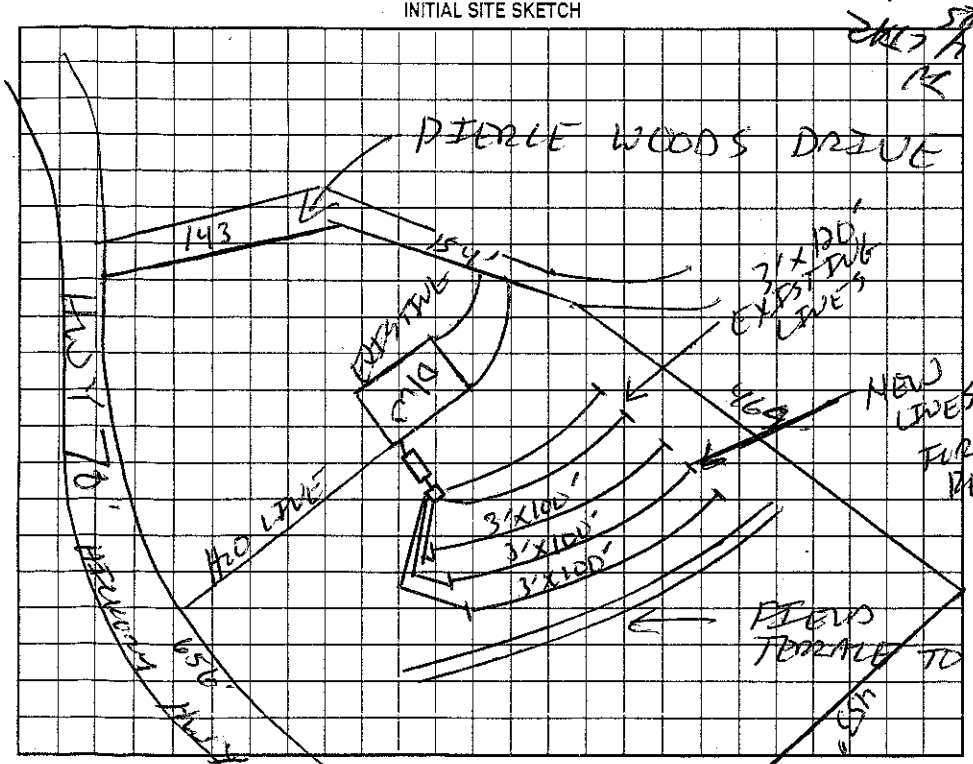

AS BUILT SKETCH

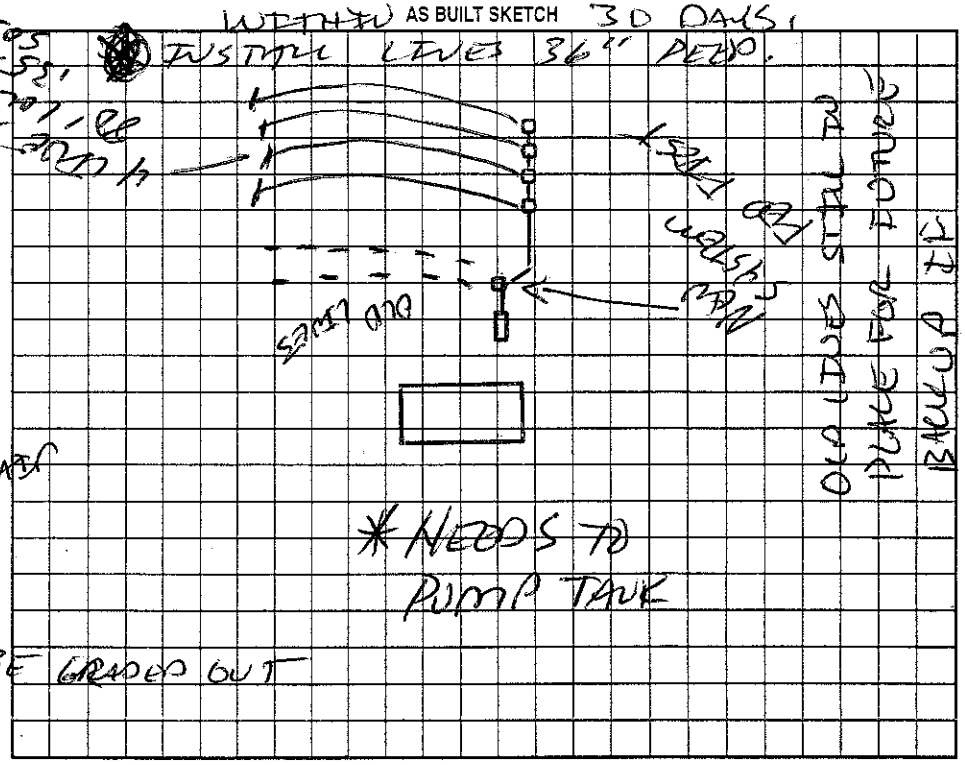

Permit can be suspended or revoked if any false information is supplied toward securing the permit/any unauthorized changes are made to the site/any unauthorized changes are made in the installation of the system. Improvement Permit with plat valid without expiration. Improvement Permit with site plan valid for sixty months. Authorization to Construct is valid for a period equal to that of Improvement Permit – not to exceed sixty months.

Signed: Theodore R Thompson date 6-2-04 Installed by: CRAIG THOMPSON

Improvement Permit by: date 6-2-04 Operation Permit by: date 5-26-05

Authorization to Construct by: date 6-2-04 Existing System Inspection by: date

HEALTH DEPT. COPY: WHITE OWNER COPY (FINAL): YELLOW OWNER COPY (INITIAL): PINK