IREDELL COUNTY HEALTH DEPARTMENT

Statesville Office (704) 878-5305 Mooresville Office (704) 660-3625 PERMIT # 216715

IMPROVEMENT PERMIT / AUTHORIZATION TO CONSTRUCT / OPERATION PERMIT / EXISTING SYSTEM

PIN # 3792-14-9603.000

APPLICANT: Oakwood Homes APPLICANT ADDRESS: 1265 Hwy 70 W - Newton 28638

SITE ADDRESS: 4272 Hickory Hwy Statesville NC PHONE: 828-464-2662 ALT. PHONE: 704-880-7814

SITE DIRECTIONS: I-40 E, Exit 141 TR, Hwy 70 TR, Lot on R


SUBDIVISION: Earl & Cindy Edmonson Family Sub. SECTION: — LOT # 2 LOT AREA: .66 Acre DESIGN FLOW: 360 GPD L.T.A.R.: .35 I / .3 R

Septic Tank	1000	(gal)	STB	160	Date	4-14-16	☒ New System	☐ Repair	☐ Expansion	System Type: I II ☒ III IV V VI	☒ Residence	No. Bedrooms 3	Water Supply
Pump Tank	N/A	(gal)	PT	N/A	Date	N/A	System Description: 25% Reduction - Gravity				☐ Business	No. Persons 6	☐ Private
Pump Make	N/A	Model	Poly Tank		Serial #	RL-64	Repair System Description: LP-PUMPS				☐ Other	No. Employees	☒ Public
# Nitrification Fields	1	# Lines	3 @ 86'		Linear Ft:	258'	Maintenance Agreement Required:	☐ YES	☒ NO		☐ Slab	☒ Crawl Space	☐ Community
Trench Width	36"	Max. Trench Bottom Depth*	33" Low Side*		Gravel Depth	N/A		☒ GRAVITY	☐ PRESSURE		☐ Basement w/plumbing		☐ Basement w/o plumbing


Comments / Conditions: Install 1 Drainfield 33"-36" Deep.
If water line is encountered, reroute to 10' Horizontal Separation.
Maintain 100' from Bored Well.

Fill any 1 Drainage in Septic Area.
Proposed Property Lines Must Be Recorded Prior To Issuance of AC.
Easement Must Be Recorded Prior To Issuance of AC.

INITIAL SITE SKETCH

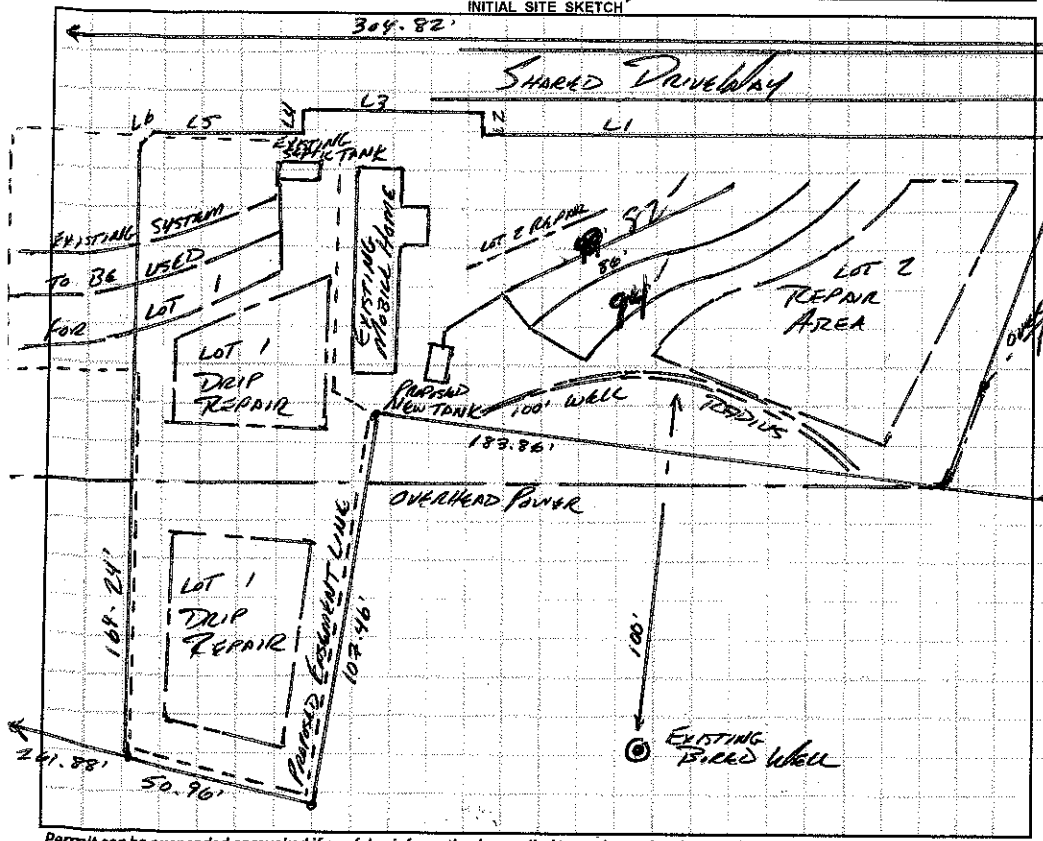

AS BUILT SKETCH

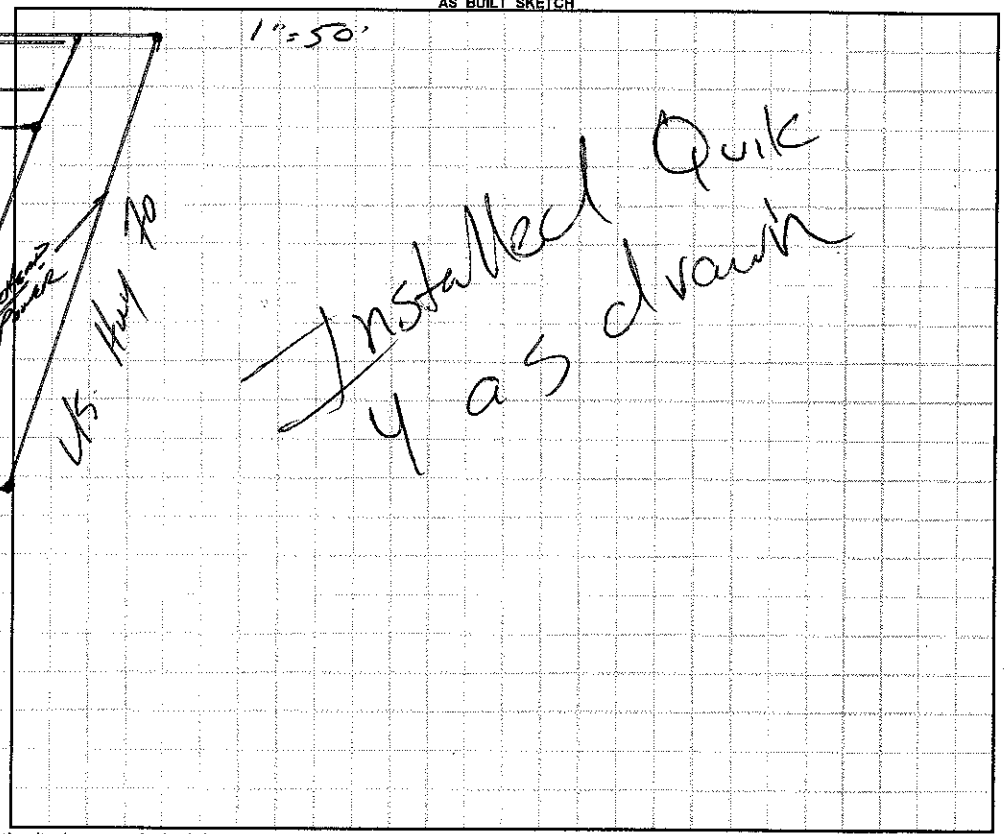

Permit can be suspended or revoked if any false information is supplied toward securing the permit / any unauthorized changes are made to the site / any unauthorized changes are made in the installation of the system. **CONTACT A LOCATOR SERVICE PRIOR TO ANY EXCAVATION**

☐ **IMPROVEMENT PERMIT** *with plat valid without expiration.* ☒ **IMPROVEMENT PERMIT** *with site plan valid for 60 mos.* ☒ **AUTHORIZATION TO CONSTRUCT** *valid for period equal to IMPROVEMENT PERMIT--not to exceed 60 mo.*

Owner / Applicant Signature: Date: 6/14/16 Installed by: Abees Landscaping

IMPROVEMENT PERMIT by: APPROVED MAY 24 2016 OPERATION PERMIT by: Date: 06/29/16

AUTHORIZATION TO CONSTRUCT by: APPROVED JUN 13 2016 Existing System Inspected by: Date:

Health Dept. Copy - WHITE Applicant (Final Approval) - YELLOW Applicant (Conditional Approval) - PINK