IREDELL COUNTY HEALTH DEPARTMENT

STATESVILLE 704-878-5305 MOORESVILLE 704-664-5281

IMPROVEMENT PERMIT / AUTHORIZATION TO CONSTRUCT / OPERATION PERMIT / EXISTING SYSTEM INSPECTION

PERMIT# 078124 PIN# 3792 29 4342 DATE 1-23-99

OWNER OR CONTRACTOR WEST IREDELL FIRE DEPT. PHONE: Business 872-3947 Home

ADDRESS 139 N. SHARON RESTRD, STVL, NC 28677

LOCATION I-40 WEST, TL SHARON SCHOOL ROAD, LOT ON LEFT AT OLEY LANE

SUBDIVISION BLOCK / SECTION LOT LOT AREA 2.371 ACRES SITE CLASS PS DESIGN FLOW 200 L.T.A.R. 0.30 GPD/FT²

Septic Tank: 1000 Gallons; STB 1012 Date 10-14-00
Pump Tank: Gallons; PT Date
Pump Make: Model Serial No.
Nitrification Field: No Fields 1 Square Feet 675 Linear Feet 225
No Lines TWO Trench Width 36" Max Trench Bottom Depth 36" Gravel Depth 12"

☑ New System ☐ Repair System Type: I (II) III IV V VI
System Description: CONVENTIONAL, GRAVITY
Repair System Description: CONV. GRAVITY
Maintenance Agreement Required: ☐ Yes ☑ No
☑ Slab ☐ Crawl Space ☐ Basement w/plumbing ☐ Basement wo/plumbing


☐ House/Mod. Home No. Bedrooms 2
☐ Mobile Home No. Bathrooms 2
☐ Business UNMANNED Employees
☑ Other FIRE SUBSTATION

Water Supply: ☐ Individual ☑ Public ☐ Community


Comments/Conditions:

Comments/Conditions Septic Tank Risers Installed
-Aeylok Filter Installed

INITIAL SITE SKETCH

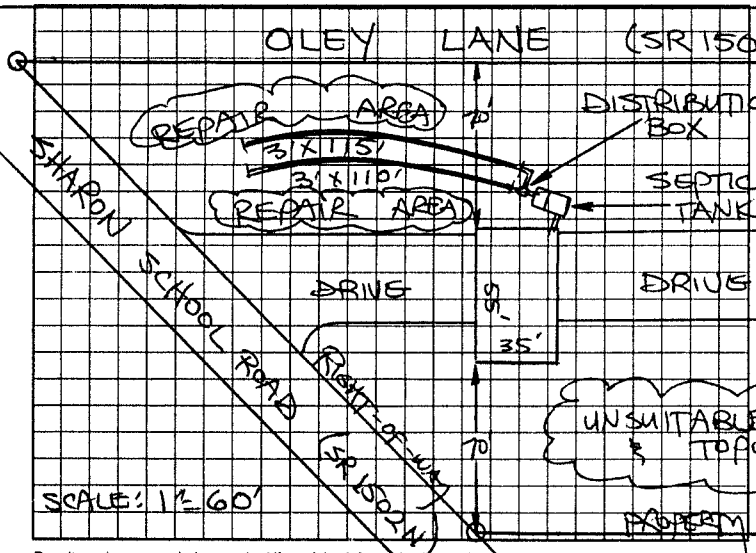

AS BUILT SKETCH

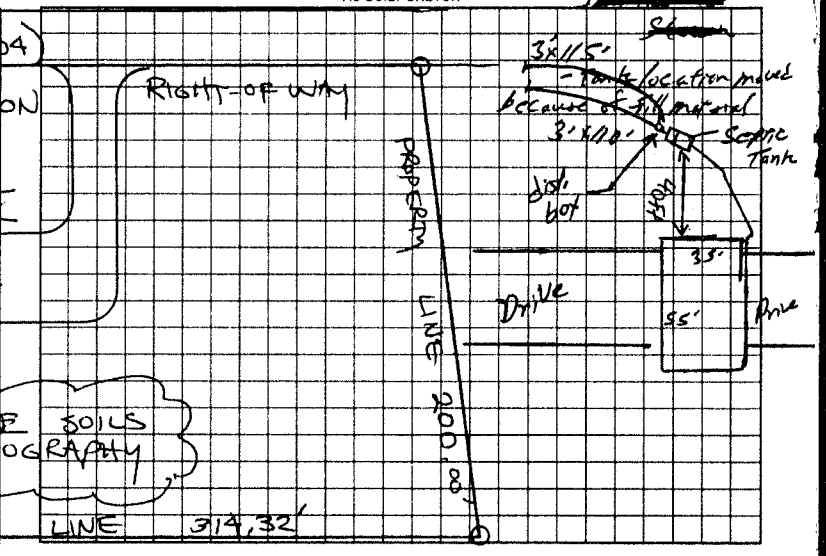

Permit can be suspended or revoked if any false information is supplied toward securing the permit/any unauthorized changes are made to the site/any unauthorized changes are made in the installation of the system. Improvement Permit with plat valid without expiration. Improvement Permit with site plan valid for sixty months. Authorization to Construct is valid for a period equal to that of Improvement Permit - not to exceed sixty months.

Signed: Jonah C. Hahn date 1-26-99 Installed by: ESKer Elder

Improvement Permit by: STEVE HEDRICK date 1-23-99 Operation Permit by: William O. Johnson RS date 4-27-01

Authorization to Construct by: STEVE HEDRICK date 1-23-99 Existing System Inspection by: date

HEALTH DEPT COPY WHITE OWNER COPY (FINAL) YELLOW OWNER COPY (INITIAL) PINK