IREDELL COUNTY HEALTH DEPARTMENT

Statesville Office (704) 878-5305 Mooresville Office (704) 660-3625 PERMIT # 216373 ~~181517~~

IMPROVEMENT PERMIT / AUTHORIZATION TO CONSTRUCT / OPERATION PERMIT / EXISTING SYSTEM

PIN # 3792235038 ✓

APPLICANT: KAREN & THOMAS KEESEE APPLICANT ADDRESS: 132 FRALEY RD

SITE ADDRESS: 159 PIERCE WOODS DR. PHONE: ALT. PHONE: 704-657-8421


SITE DIRECTIONS: 70 W - TL PIERCEWOODS JUST PAST STATESVILLE BRICK - AT END

SUBDIVISION: — SECTION: — LOT # — LOT AREA: 7.5AC DESIGN FLOW: 240 L.T.A.R.: .25


Septic Tank	1000 (gal)	STB	160	Date	1-8-16	☑ New System	☐ Repair	☐ Expansion	System Type: I II (III) IV V VI	☑ Residence	No. Bedrooms 2	Water Supply
Pump Tank	(gal)	PT		Date		System Description:	GRAVITY 25% REDUCTION			☐ Business	No. Persons 4	☑ Private
Pump Make		Model		Serial #		Repair System Description:	GRAVITY 25% REDUCTION			☐ Other	No. Employees	☐ Public
# Nitrification Fields	1	# Lines	3	Linear Ft:	240	Maintenance Agreement Required:	☐ YES	☑ NO		☐ Slab	☑ Crawl Space	☐ Community
Trench Width	36"	Max. Trench Bottom Depth	36"	Gravel Depth	N/A		☑ GRAVITY	☐ PRESSURE		☐ Basement w/plumbing	☐ Basement w/o plumbing	

Comments / Conditions: 1"=100'

INITIAL SITE SKETCH

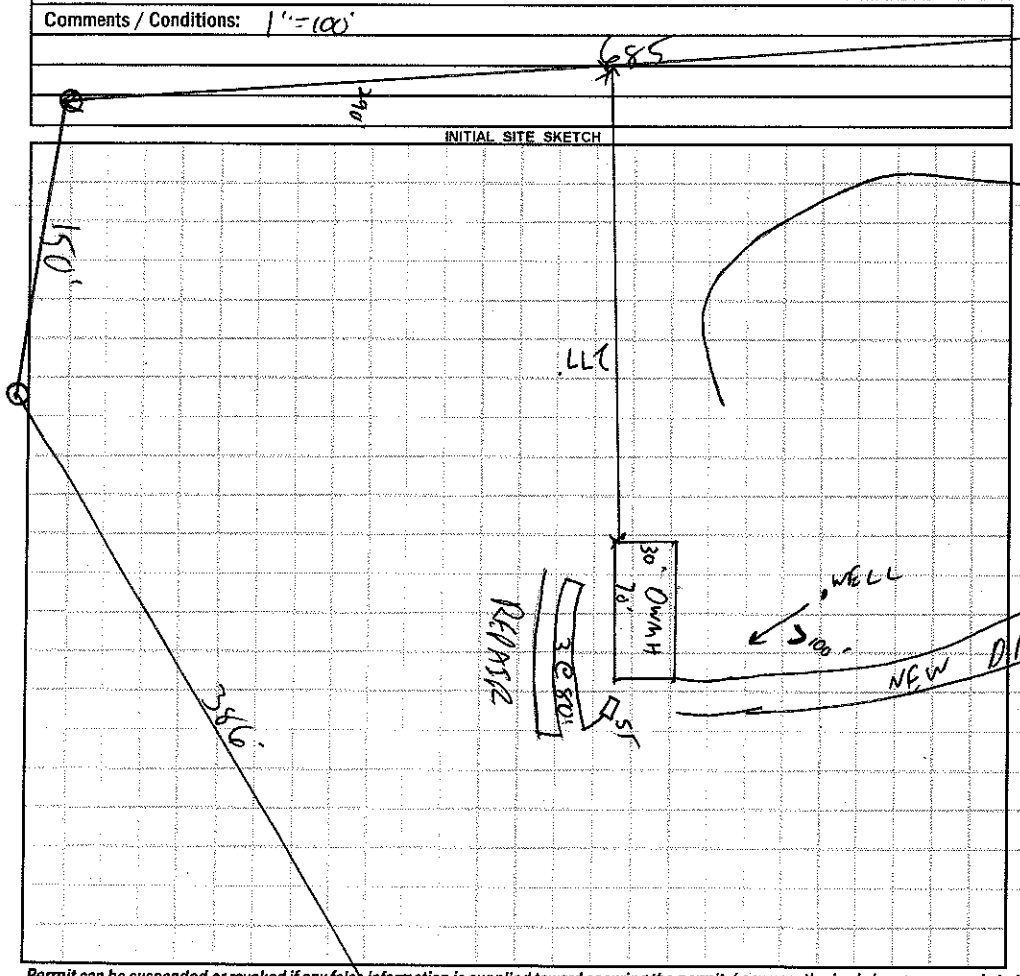

AS BUILT SKETCH

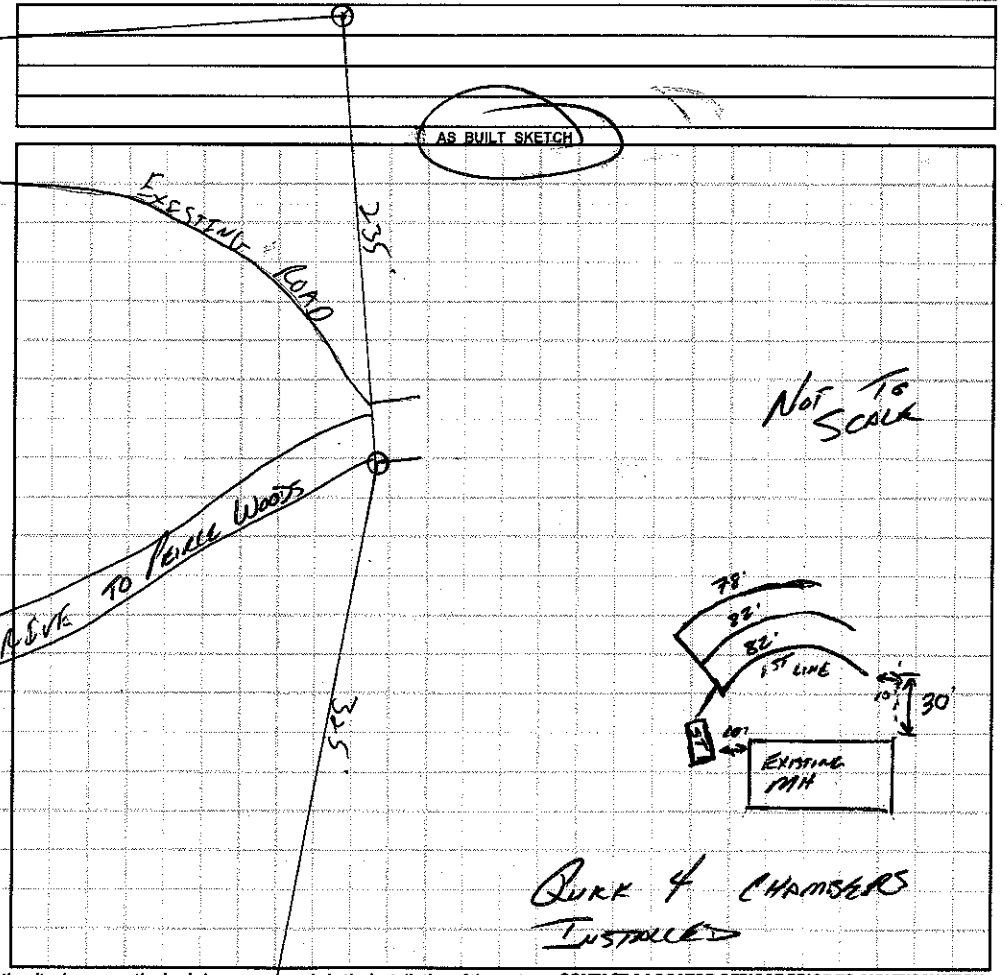

Permit can be suspended or revoked if any false information is supplied toward securing the permit / any unauthorized changes are made to the site / any unauthorized changes are made in the installation of the system. **CONTACT A LOCATOR SERVICE PRIOR TO ANY EXCAVATION**

☐ **IMPROVEMENT PERMIT** *with plat valid without expiration.* ☑ **IMPROVEMENT PERMIT** *with site plan valid for 60 mos.* ☐ **AUTHORIZATION TO CONSTRUCT** *valid for period equal to IMPROVEMENT PERMIT--not to exceed 60 mo.*

Owner / Applicant Signature: Karen Banks Keesee Date: Installed by: Shawn Abee

IMPROVEMENT PERMIT by: C. Bailey Ferguson REHS Date: 10/24/13 OPERATION PERMIT by: Date: 3/9/16

AUTHORIZATION TO CONSTRUCT by: REHS Date: 10/24/13 Existing System Inspected by: Date:

Health Dept. Copy - WHITE Applicant (Final Approval) - YELLOW Applicant (Conditional Approval) - PINK