IREDELL COUNTY HEALTH DEPARTMENT

STATESVILLE 704-878-5305 MOORESVILLE 704-664-5281

IMPROVEMENT PERMIT / AUTHORIZATION TO CONSTRUCT / OPERATION PERMIT / EXISTING SYSTEM INSPECTION

PERMIT # 160351 PIN # 3798-24-3981 DATE 7 April 10

OWNER or APPLICANT Jennifer Poole PHONE: Business (828) 312-1916 Home:

OWNER or APPLICANT ADDRESS 4256 Hickory Hwy Statesville

LOCATION / DIRECTIONS Hwy 70 - on Rt. past Shannon School Rd.

SUBDIVISION BLOCK / SECTION LOT # LOT AREA 3.5 Ac. DESIGN FLOW 240 gpd L.T.A.R. 0.3 gal/ft²/d

Septic Tank 1000 Gallons: STB 179 Date 3-16-10

Pump Tank Gallons: PT Date

Pump Make Model Serial #

Nitrification Field No Fields 1 No Lines 3 Linear Feet 200

Trench Width 36" Max. Trench Bottom Depth 36" Gravel Depth NA

☑ New System ☐ Repair ☐ Expansion System Type I II III IV V VI

System Description: 25% Reduction

Repair System Description: 25% Reduction

Maintenance Agreement Required ☐ YES ☒ NO

☑ GRAVITY ☐ PRESSURE

☑ Residence No. Bedrooms 2

☐ Business No. Persons

☐ Other No. Employees

☐ Slab ☑ Crawl Space


☐ Basement w/plumbing ☐ Basement w/o plumbing

Water Supply: ☐ Private ☑ Public ☐ Community


Comments / Conditions: Follow contour / Honor setbacks /

Comments / Conditions: Poly/lock flat -

INITIAL SITE SKETCH

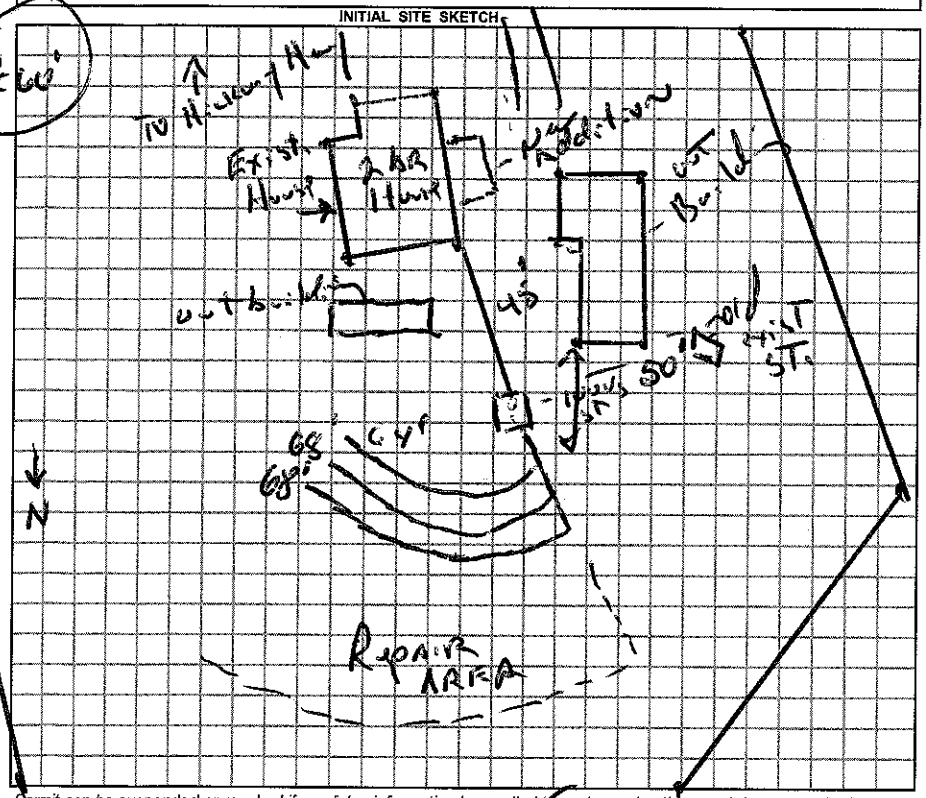

AS BUILT SKETCH

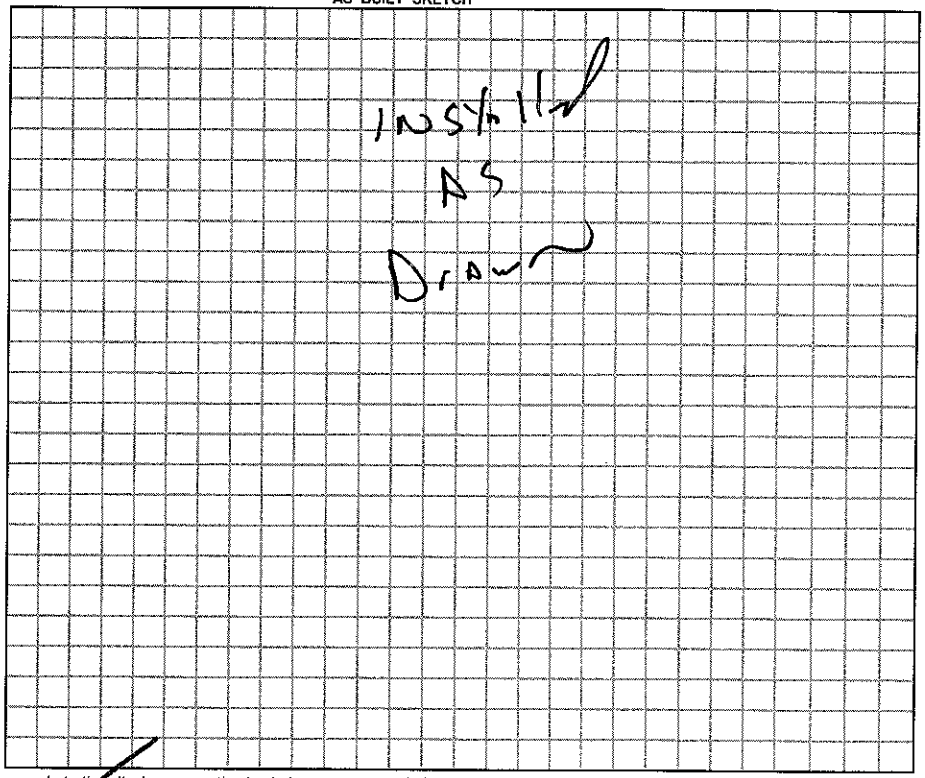

Permit can be suspended or revoked if any false information is supplied toward securing the permit / any unauthorized changes are made to the site / any unauthorized changes are made in the installation of the system.

☐ *IMPROVEMENT PERMIT w / plat valid without expiration.* ☑ *IMPROVEMENT PERMIT w / site plan valid for 60 mos.* ☑ *AUTHORIZATION TO CONSTRUCT valid for period equal to IMPROVEMENT PERMIT-not to exceed 60 mo.*

Owner / Applicant Signature: Date 4-8-10

Improvement Permit by: Date 7 April 10

Authorization to Construct by: Date 7 April 10

Installed by: Jerry Hildebran - # 3650

Operation Permit by: , R.S. Date: 30 Aug 10

Existing System Inspected by: Date:

YOU SHOULD CONTACT A LOCATOR SERVICE PRIOR TO ANY EXCAVATION.

WHITE COPY Environmental Health YELLOW COPY (Final) Owner / Applicant PINK COPY (Initial) Owner / Applicant