IREDELL COUNTY HEALTH DEPARTMENT

Statesville Phone TR 3-7271 Mooresville Phone NO 3-1271

PERMIT TO INSTALL SEPTIC TANK

Permit NO. _____ John Hope Bldg. Permit Date 11 - 29 1960

Owner Roy Pinson Address _____

Installed By CLYDE HOPE Address Rte. 7 city


Location of Property On left beyond Clinker Brick before weigh Sta.

Tank		Capacity		Length of Lines		Fixtures	
Block	( )	800	( )	150'	( )	No. of Baths	( )
Precast	(✓)	900	( )	175'	( )	Dishwasher	( )
Fast		1000	(✓)	200'	( )	Garbage Grdr.	( )
		1100	( )	225'	(✓)	Auto-Washer	( )
		1200	( )	250'	( )	Other	
		Other		Other			

NOTIFY HEALTH DEPARTMENT AT LEAST EIGHT HOURS BEFORE TANK IS TO BE INSPECTED.

Final Inspection 11-29 1960 Approved ( ) Disapproved ( )

Remarks Well 65'

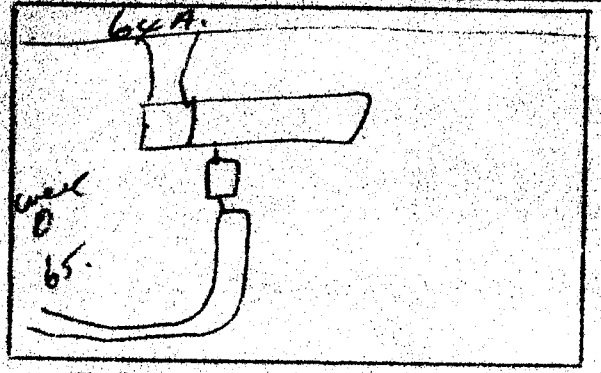

Sketch of Installation

Sel Hope.

Sanitarian