IREDELL COUNTY HEALTH DEPARTMENT

STATESVILLE 704-878-5305 ✓ MOORESVILLE 704-664-5281

✓ IMPROVEMENT PERMIT / AUTHORIZATION TO CONSTRUCT / OPERATION PERMIT / EXISTING SYSTEM INSPECTION

DATE 6/6/02

PERMIT# 106485 PIN# 3792-26-3732 PHONE: Business — Home (828) 464-8715

OWNER OR CONTRACTOR Sue Stewart

ADDRESS 1255 Hwy 70 West Newton, N.C. 28658

LOCATION I-40 W, (L) Sharon School Rd, (R) on Hazeline Drive, About ¼ mile on left, before orange gate

SUBDIVISION — BLOCK / SECTION — LOT — LOT AREA 1.91 Ac. SITE CLASS PS DESIGN FLOW 360 L.T.A.R. .30

Septic Tank: 1,000 Gallons; STB 10/2 Date 2-1-02

Pump Tank: Gallons; PT Date

Pump Make: Model Serial No

Nitrification Field: No Fields 1 Square Feet 1200 Linear Feet 300

No Lines 5 Trench Width 36" Max Trench Bottom Depth 36" Gravel Depth 12"

☒ New System ☐ Repair System Type: I, II, (III), IV, V, VI

System Description: 25% Reduction Gravity

Repair System Description: 50% Reduction Gravity

Maintenance Agreement Required: ☐ Yes ☒ No

☐ House/Mod. Home ☒ Mobile Home ☐ Business ☐ Other

No. Bedrooms 3 No. Bathrooms 2 No. Employees


Water Supply: ☒ Individual ☐ Public ☐ Community

☐ Slab ☒ Crawl Space ☐ Basement w/plumbing ☐ Basement wo/plumbing


Comments/Conditions: (1) Install 25% Reduction System on Contour (2) Keep well 100 ft from Septic System (Not to Scale)

Comments/Conditions:
- poly tank filter Installed
- Septic Tank Marker Installed
- 300 Ft of Infiltrator Chambers Installed

INITIAL SITE SKETCH

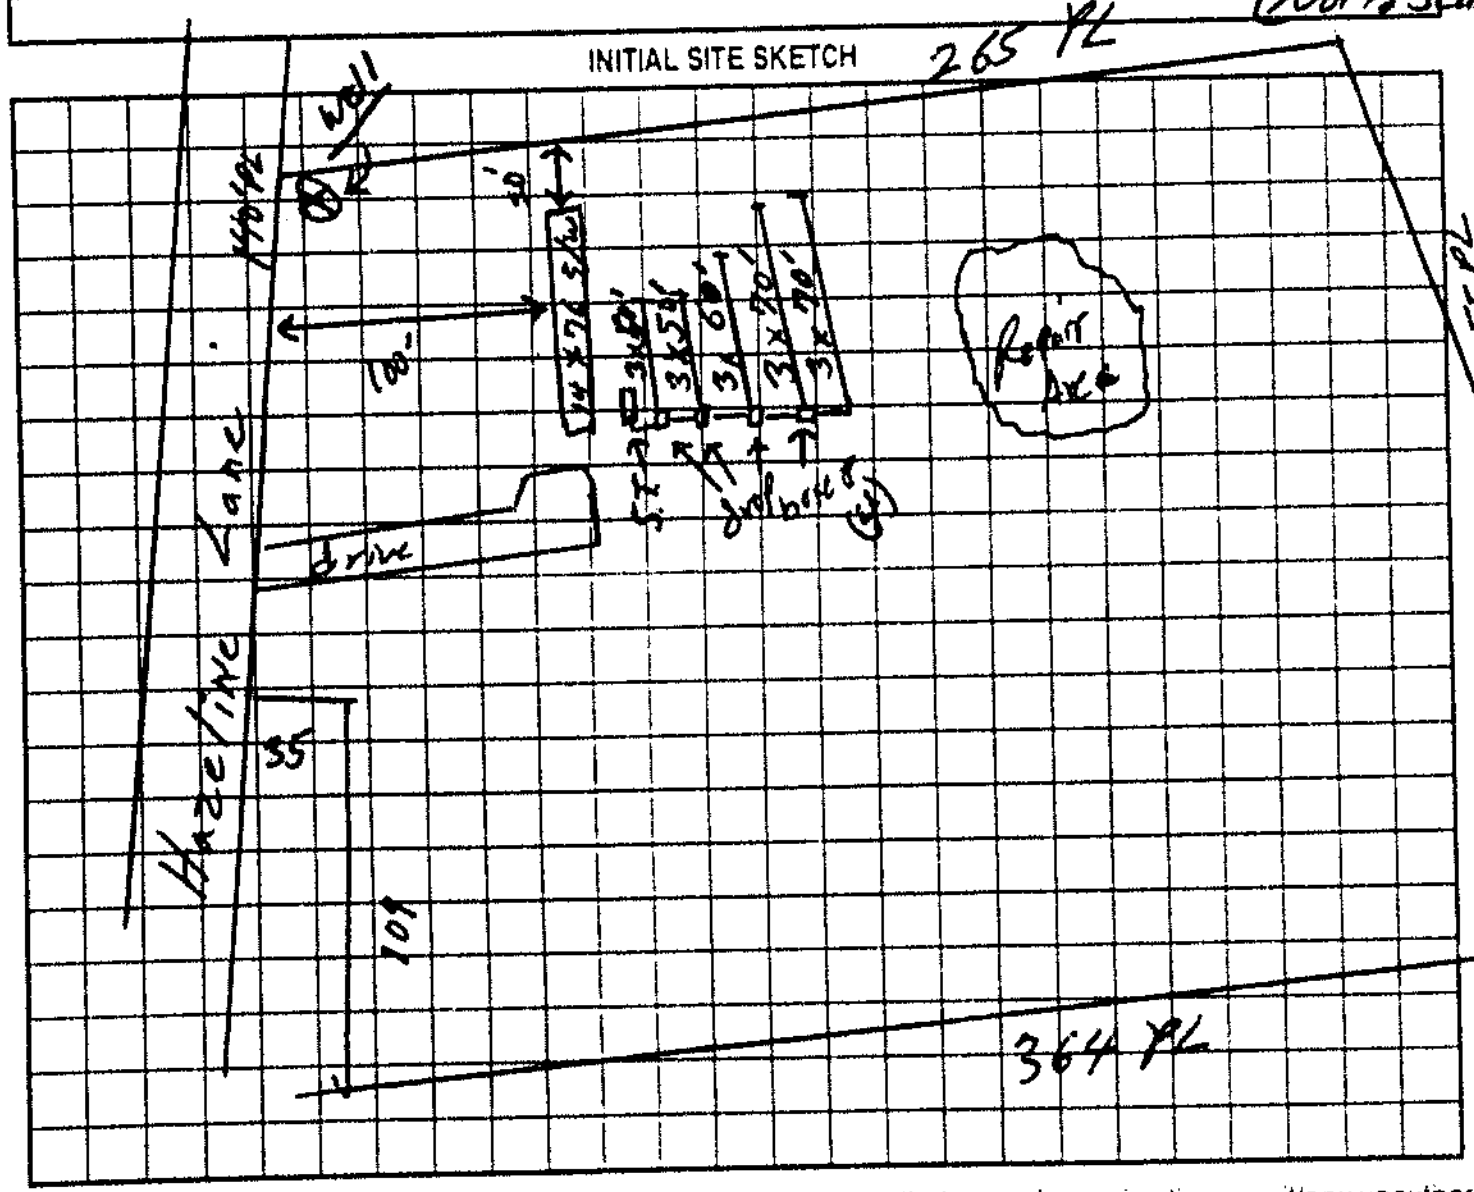

AS BUILT SKETCH

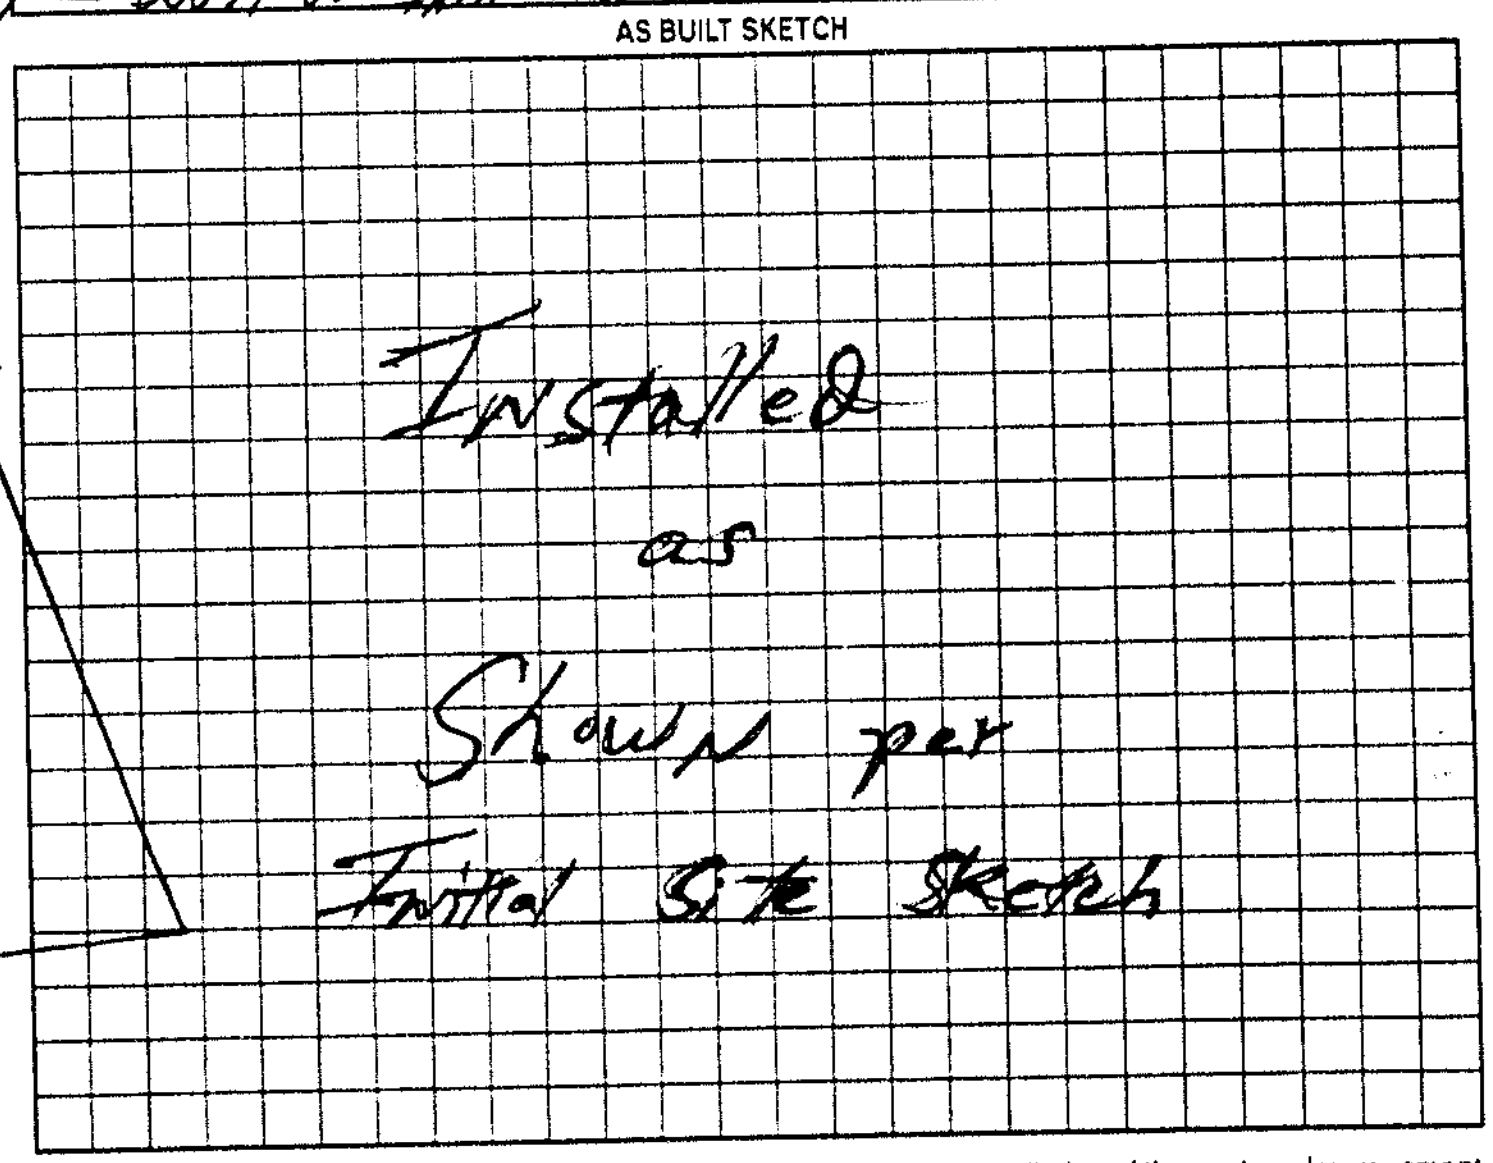

Permit can be suspended or revoked if any false information is supplied toward securing the permit/any unauthorized changes are made to the site/any unauthorized changes are made in the installation of the system. Improvement Permit with plat valid without expiration. Improvement Permit with site plan valid for sixty months. Authorization to Construct is valid for a period equal to that of Improvement Permit - not to exceed sixty months

Signed: [signature] date 6-6-02 Installed by: Craig Thompson

Improvement Permit by: William O. Johnson date 6/6/02 Operation Permit by: William O. Johnson date 6/14/02

Authorization to Construct by: William O. Johnson date 6/6/02 Existing System Inspection by: date

HEALTH DEPT COPY WHITE OWNER COPY (FINAL) YELLOW OWNER COPY (INITIAL) PINK