IREDELL COUNTY HEALTH DEPARTMENT

Due $180.00 — This permit voids previously issued permit dated 5/14/02.

STATESVILLE 704-878-5305 OR MOORESVILLE 704-664-5281

IMPROVEMENT PERMIT / AUTHORIZATION TO CONSTRUCT / OPERATION PERMIT / EXISTING SYSTEM INSPECTION

PERMIT# 105125 PIN# 3792-29-0762 DATE 12/31/02

OWNER OR CONTRACTOR Aljamel Stephens PHONE: Business — Home (704) 871-9589

ADDRESS 1820-A Simmerton Drive Statesville, N.C. 28677

LOCATION I-40 W, (L) Sharon School Rd, (L) on Oley Lane, behind 1st house on Left

SUBDIVISION — BLOCK / SECTION — LOT — LOT AREA .825 SITE CLASS. PS DESIGN FLOW 480 L.T.A.R. .30 gpd/ft²

Septic Tank: 4000 Gallons; STB 354 Date 2-27-01
Pump Tank: — Gallons; PT — Date —
Pump Make: — Model — Serial No. —
Nitrification Field: No Fields 1 Square Feet 1600 Linear Feet Equiv to 400'
No Lines 4 Trench Width 36" Max Trench Bottom Depth 30" Gravel Depth #4

☒ New System ☐ Repair System Type: I, II, (III), IV, V, VI
System Description: Gravity, 25% Reduction
Repair System Description: Pump, 25% Reduction
Maintenance Agreement Required: ☐ Yes ☒ No

☒ House/Mod. Home ☐ Mobile Home ☐ Business ☐ Other
No. Bedrooms 4 No. Bathrooms 3½ No. Employees —


☐ Slab ☒ Crawl Space ☐ Basement w/plumbing ☐ Basement wo/plumbing

Water Supply: ☐ Individual ☒ Public ☐ Community


Comments:/Conditions:

Comments:/Conditions:
- Poly lok filter Installed
- ST marker Installed
- Installed 58 Infiltrator Chambers

INITIAL SITE SKETCH 1" = 50'

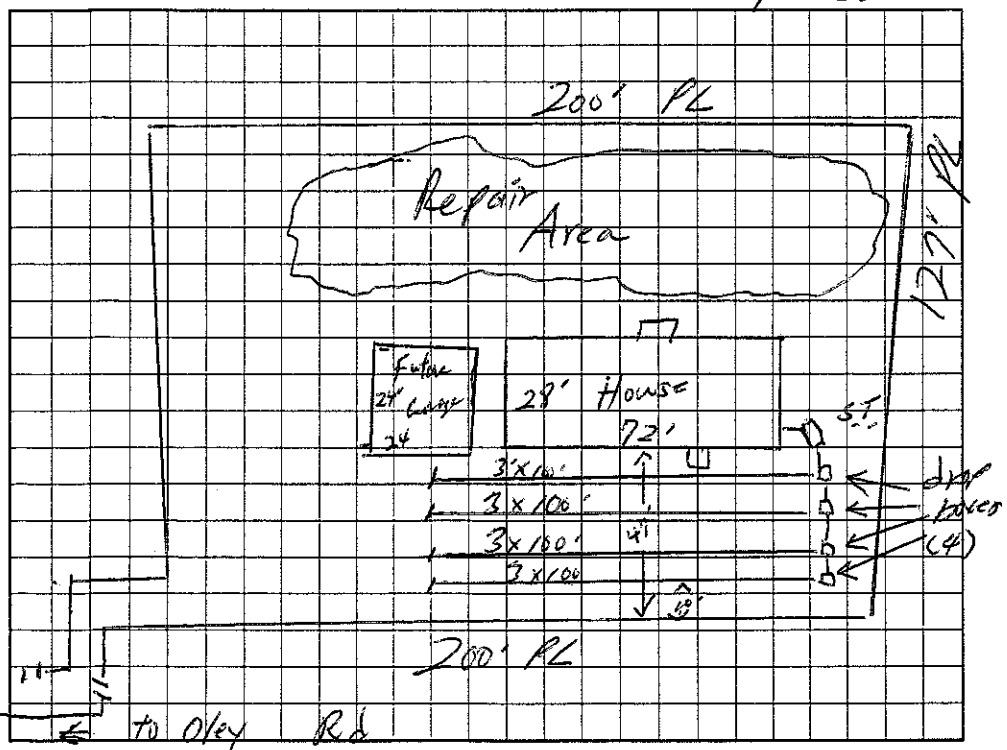

AS BUILT SKETCH

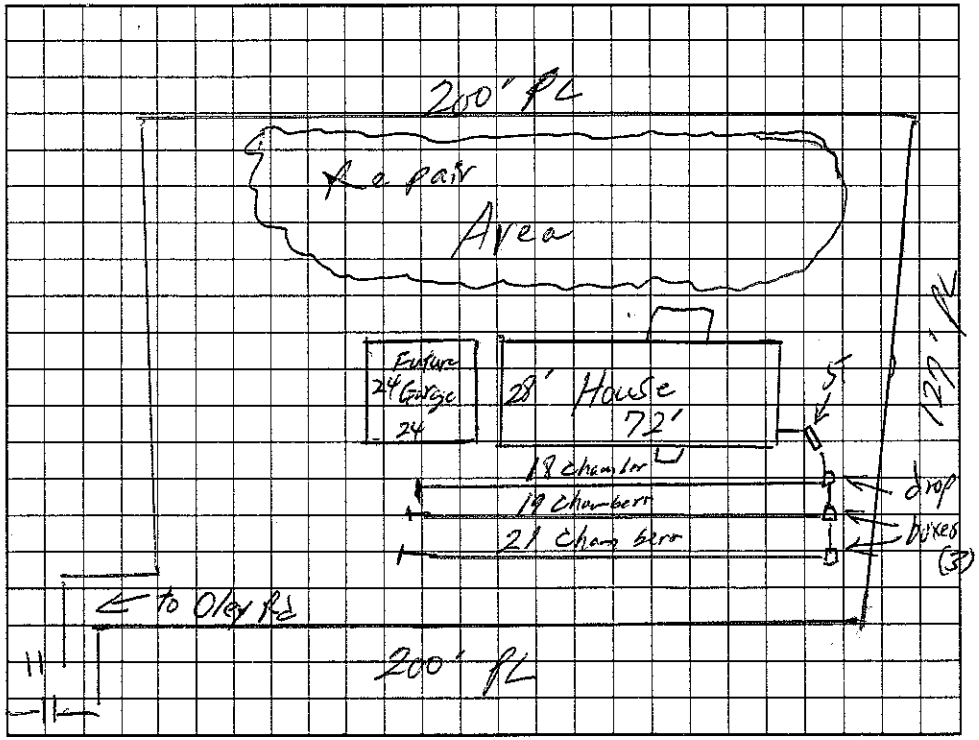

Permit can be suspended or revoked if any false information is supplied toward securing the permit/any unauthorized changes are made to the site/any unauthorized changes are made in the installation of the system. Improvement Permit with plat valid without expiration. Improvement Permit with site plan valid for sixty months. Authorization to Construct is valid for a period equal to that of Improvement Permit – not to exceed sixty months.

Signed: A. Stephens date 12/31/02

Improvement Permit by: William O. Johnson date 12/31/02

Authorization to Construct by: William O. Johnson date 12/31/02

Installed by: C + M Enterprise

Operation Permit by: William O. Johnson date 4/17/03

Existing System Inspection by: — date —

HEALTH DEPT. COPY: WHITE OWNER COPY (FINAL): YELLOW OWNER COPY (INITIAL): PINK